


Final boundary to
coincide with S body
of 1st add to Waites
Add. Stakes on pipes
set on all lot
corners. South lines
closed. West line
follows east line of
Stephens St.

See Final Plat for
all details

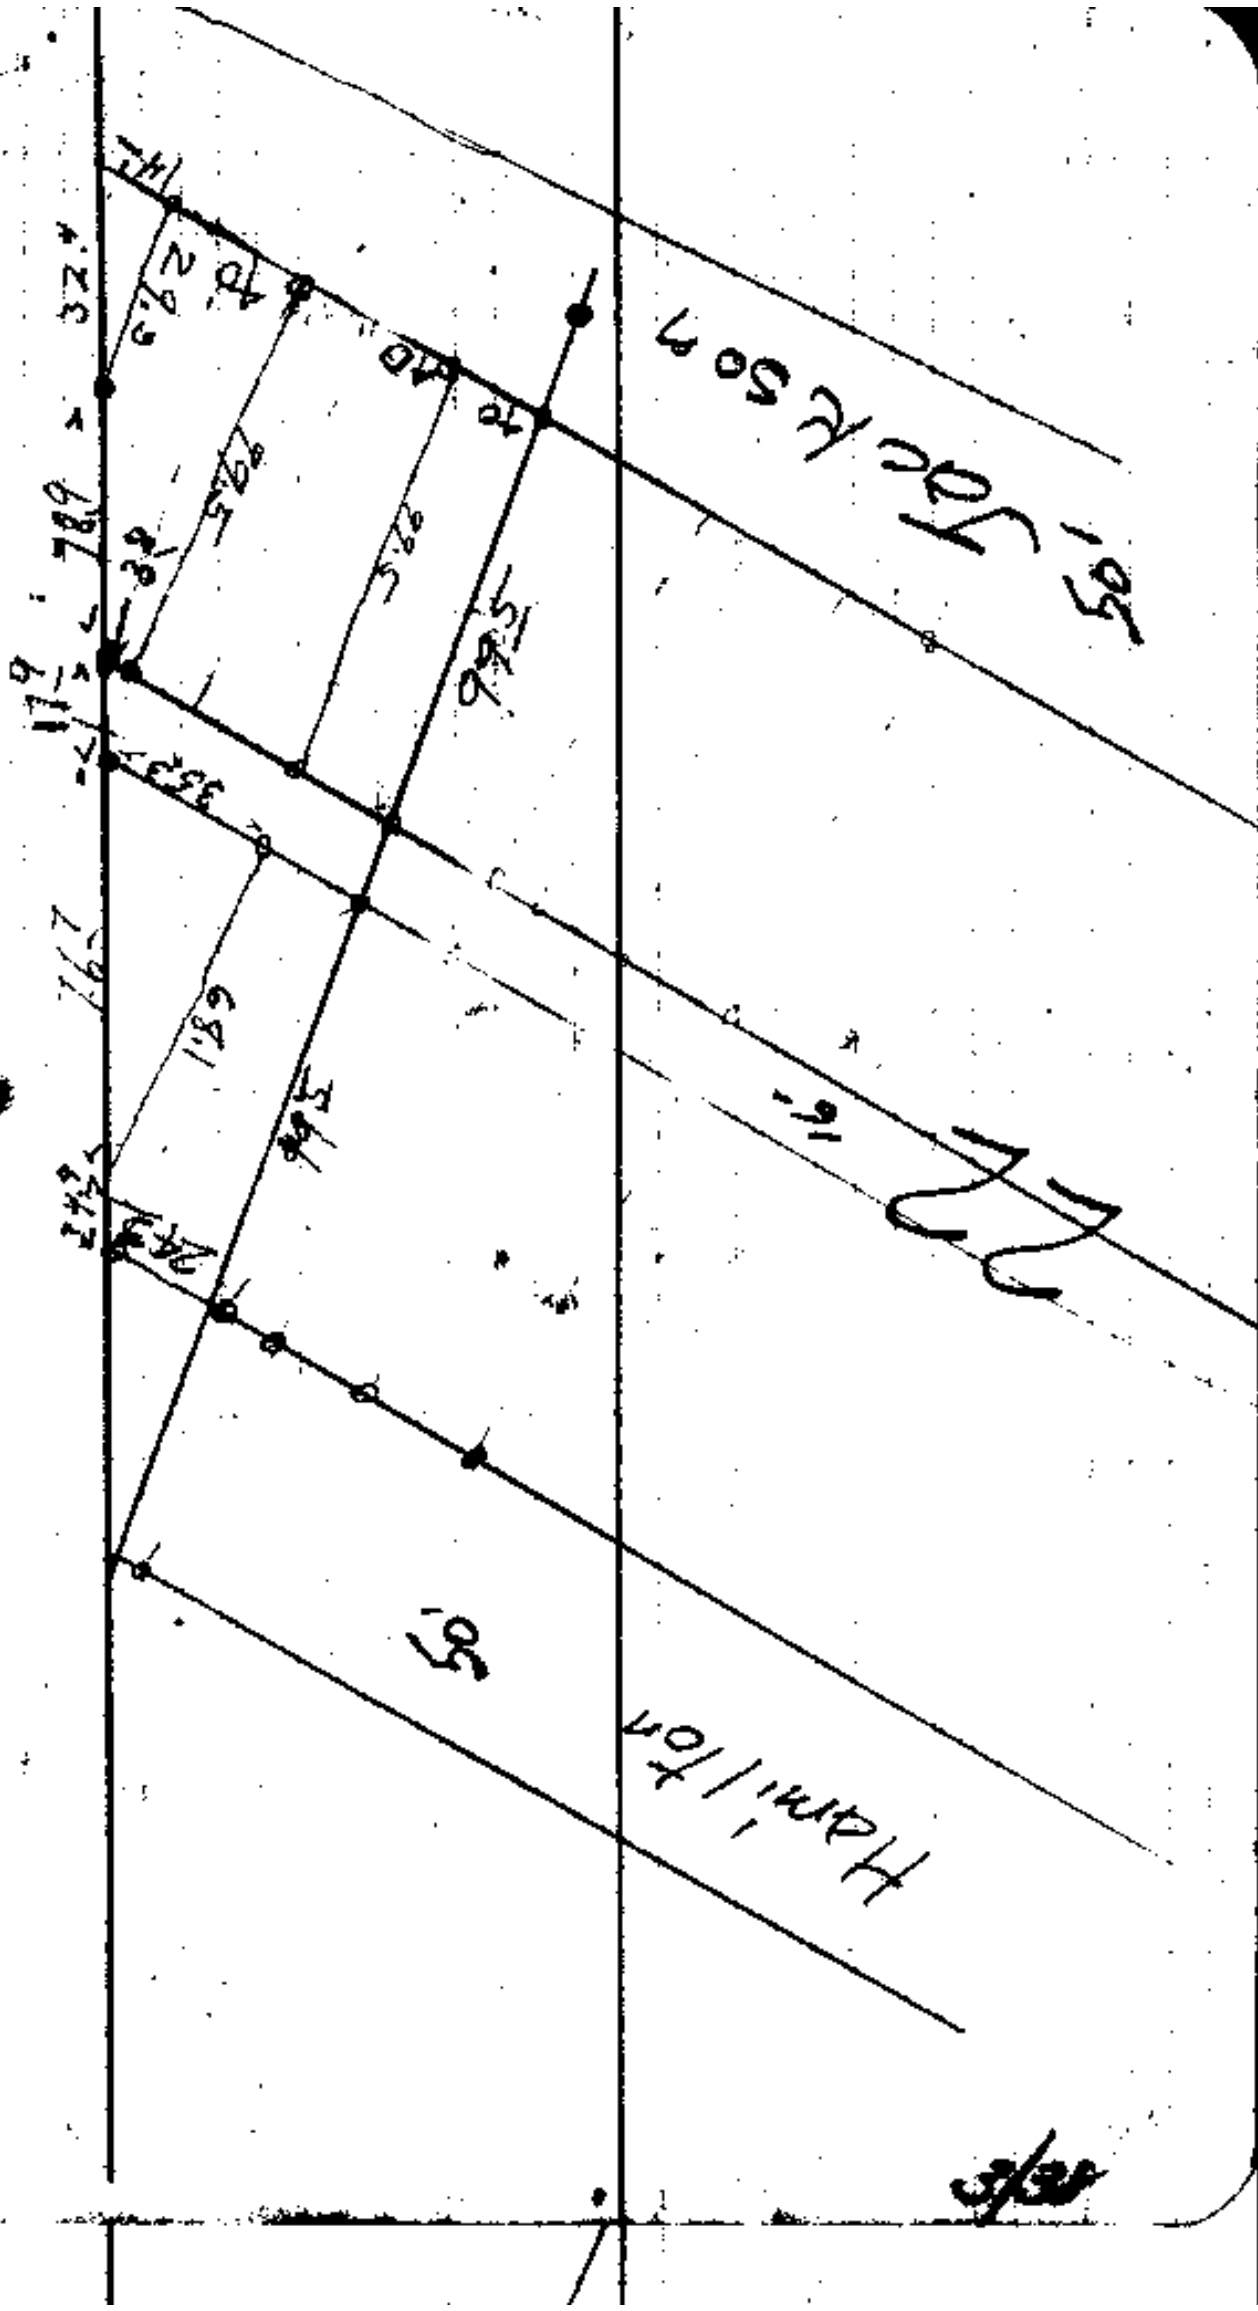


Curve on Stevens St.
 10° Curve
 Δ 23°47
 L 237.83
 T 120.67
 R 573.0

Inside Curve on Property Line
 R 573.0
 Δ 23°47 = 1153
 10°34' C
 T 104.20
 L 225.08

0+00
 +25 1-19
 +50 2-38
 +75 3-57
 1+00 5-17
 +25 6-36
 +50 7-55

1+97⁵ 10-26
 2+00 10-34
 +25 11-53

Cobb

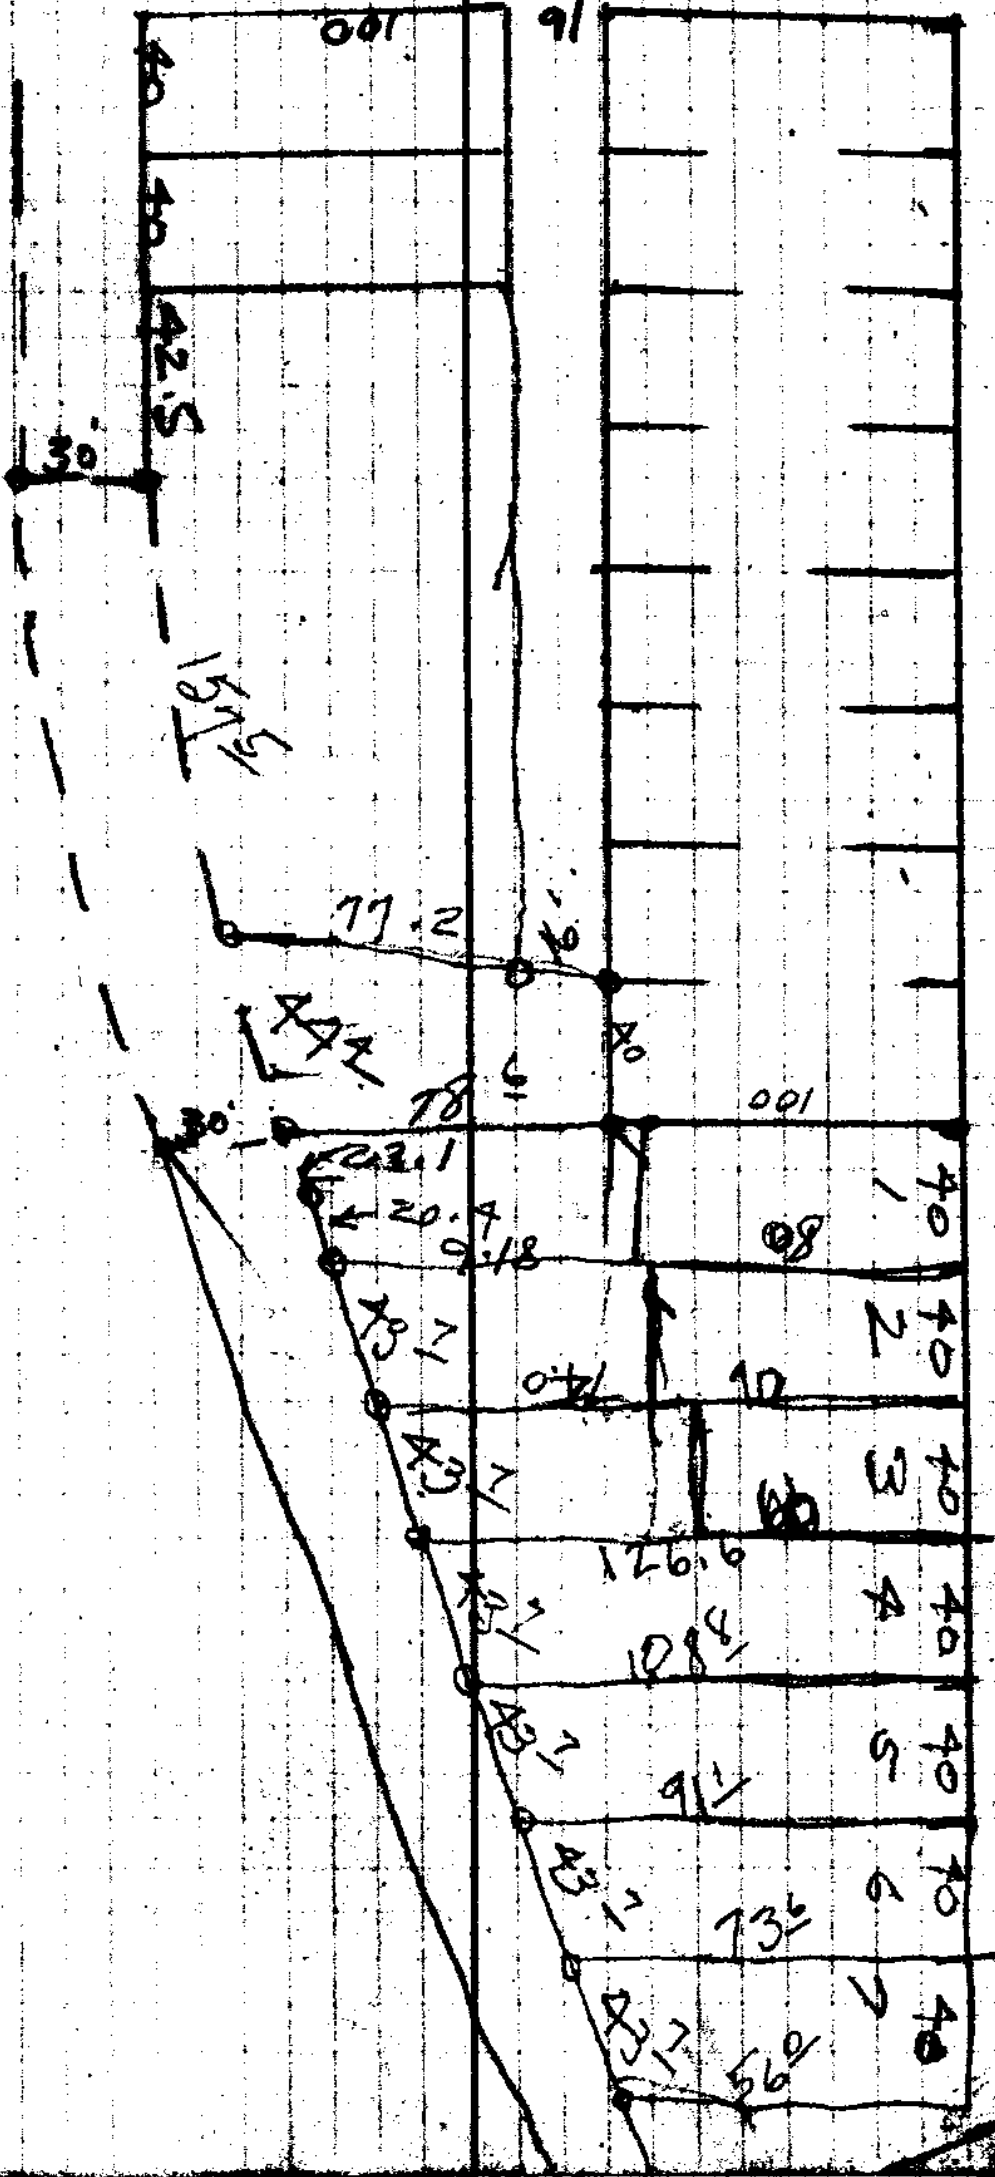

200
42.5
157.5

Bldg.

under Ball

116'

Rice

Ham

25

12.0

120

40 40 40 40 40

100

19/8