

T. 21-7 B.T.

N.W. Cor. Bl. 48 - Oak Plate -  $S. 83\frac{1}{4}^{\circ} E - 8.04 ch.$   
N.E. " " 48 - " " Old B.T. a.w.d.  $14^{\circ} S. 85^{\circ} W. - 4.50 ch.$

Ext. "2" Cor. a.w.d.  $30^{\circ} - N. 65^{\circ} W. - 27 LK$  - supposed to be tree  
Samel  $N. 74^{\circ} W. - 35 "$

Int "2" Cor. a.w.d.  $10^{\circ} - S. 27\frac{1}{2}^{\circ} W. - 55 LK$  \*

Ext. 2. Cor. Det Rock <sup>Old</sup>  $24^{\circ} N. 45^{\circ} W. - 104 LK$  ↓

O.W. Cor. - Det Rock Old B.T.  $N. 10^{\circ} E. - 92 LK$   
a.w.  $14^{\circ} N. 10^{\circ} E - 105 "$


$\frac{1}{4}$  Cor 13 & 24  $15^{\circ}$  Oak  $S. 80^{\circ} E. - 578$   
 $12^{\circ}$  "  $N. 87^{\circ} E. - 601$

$\frac{1}{4}$  Cor 24 & 25 B.D.  $12^{\circ} - N. 30^{\circ} W. - 38 LK$   
"  $24^{\circ} - S. 38^{\circ} W. - 66 "$

19-30-24-25 copper B.T.s.

$\frac{1}{4}$  Cor 19 & 30 a.w.d.  $18^{\circ} N. 38\frac{1}{2}^{\circ} W. - 63 LK$   
"  $8^{\circ} N. 53\frac{1}{2}^{\circ} E. - 121 "$

$\frac{1}{4}$  Cor 23 & 24 B.D.  $10^{\circ} N. 25^{\circ} E. - 14 LK$  Marko Goud  
"  $6^{\circ} S. 60^{\circ} E. - 19 "$   
"  $N. 25^{\circ} E - 64 "$

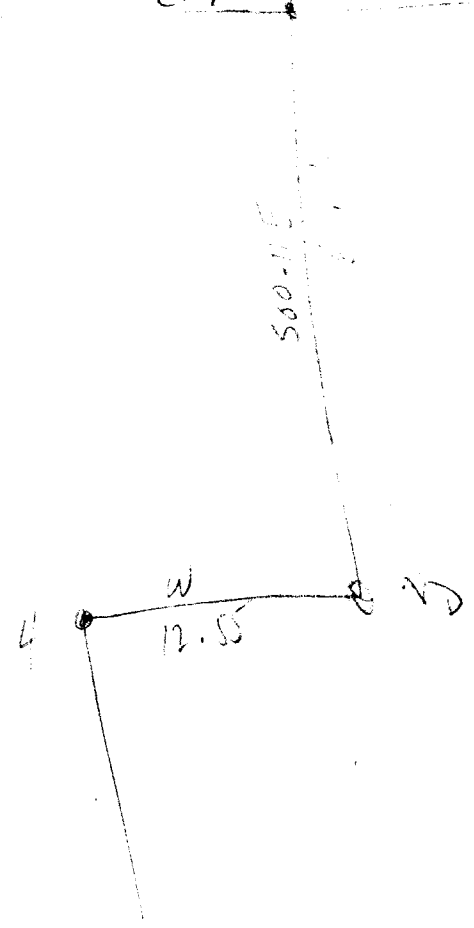

4-38

Quit Claim Deed from

Lydia Wilson

to

E.M. Seeley

Beginning at the S.E. Cor. of the Wm Morin D.L.C.No. 48 in T.27 S., R.7 W.  
W.M. Douglas Co. Oregon.

Thence N.00°11'W. 10.00 ch.

Thence West 12.55 ch.

Thence S.00°11'<sup>E</sup> 10.00 ch. to the Interior "L" Cor. of Cl.48

Thence East 12.55 ch. to the place of beginning and containing  
12.55 acres more or less, all in Sec. 24 above Tp. and Range.

---

Deed from E.M. Seeley to Lydia Wilson.

Beginning at a point on the East boundary of the Wm. Morin D.L.C.No.48  
<sup>in T.</sup>  
~~from~~ T.27 S., R.7 W., W.M. Douglas Co. Oregon. from which the S.E. Cor. of said  
Cl.48 Bears S.00° 11'E. 11.58 ch. distant.

Thence N.00° 11'W. 8.67 ch.

Thence N.89° 57'W. 0.93 ch. to the E. side of the County Road.

Thence S. 02° 00'E. 7.32 ch. along the <sup>East side</sup> ~~East side~~ of the County Road.

Thence S.27° 15'E. 1.50 ch. to the place of beginning and containing  
0.75 Acre of land more or less, all in Sec. 24 above Tp. and Range.



Beg at Pt in Sec 24 - T. 27-7  
 from wh N.W. Cor Sec 24 Bro  
 N. 89-57 W. - 1924.2 ft. and = 29.15  
 N. 00-05' E - 1324.0 ft. = 20.06

Th. D. 89-57 E - ~~1324.0~~ 1685.3 = 25.53

" A. 00-18' E. ~~1685.3~~ 1336.6 = 20.25

" D. 89-46 W. 827.1 = 12.53

" N. 89-55 W. 867.25 = 13.14

" N. 00-05' E 1345.0 to leg = 20.39  
 + Cont. 50.48 ac.

