

0.5. 4/68

4-68

585-16
 9-10
 12-30 1085
 Δ 1
 34 1412
 Δ 2
 Δ 3
 371-522
 Δ 4
 36 1429
 Δ 5
 26-30 607
 Δ 6
 Δ 7
 18-30 865
 Δ 8
 270 276
 Δ 9
 25 1621
 Δ 10
 6 1985
 Δ 11
 220 447
 Δ 12

106.2
 116.9
 165
 419
 1157
 543
 373
 820
 246
 146.9
 197.4
 962.9
 962.9

239.5
 397.2
 488.8
 939.7

West

Andrew

Turner

15 July 57 13-37
60° 00' N 67° W 84.33° W
1 0728
4811 Fm N23E 51 Ft
Marked New B.I.
B.I.
Found at bed
Preserved

June 26-27-28
R.L. Galt
B.A. L...
from Andrews
Terry Burkhoff
N.W. Andrews

Δ 12
Δ 13
Δ 14
Δ 15
Δ 16
Δ 17
Δ 18
Δ 19
Δ 20
Δ 21
Δ 22
Δ 23
Δ 24
Δ 25

286
286
1703
564
343
1056
2249
555
30
30
1173

302
492
302
12448
1320
1279.1
750
10K
10K
10K

60R
10181
56
750
15753
20R
18071

750

C. S. File No.

4/68

025
1276
12-00
27
28
Δ29
Δ30
32
33
~~30-100~~
34
30-100
Δ35
18-30
Δ36
180
Δ37

5
603
1015
1612
1460
3107
600
1663
670.1
866
694
760


N
20289
2640.0

23297

15232

16484

← man south 213 feet

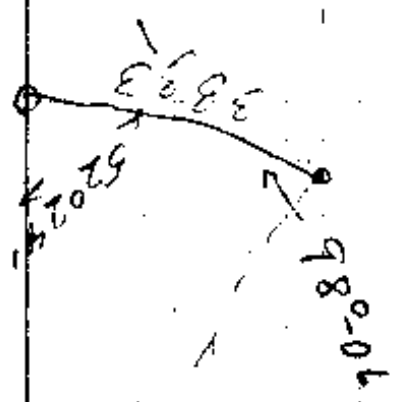

98-06
 29-30
 5224
 180-07

Δ 39
 Δ 38
 Δ 39
 Δ 40
 Δ 41
 Δ 42
 Δ 43
 Δ 44
 Δ 45
 Δ 46
 Δ 47
 Δ 48
 Δ 49

39
 36.5
 39
 117.3
 63.3
 50
 112
 40
 40
 155
 96.8

17349
 17213
 18103
 19216
 19909
 2041.0
 2153.0
 207
 211.8
 2366.8
 2463.6

sank 5 feet water

Δ 37

15-30
 Δ 38

Δ 39

13-30
 Δ 40

3-30
 Δ 41

Δ 42

Δ 43

Δ 44

Δ 45

Δ 46

Δ 47

Δ 48

Δ 49

Δ 40

Δ 41

Δ 42

Δ 43

Δ 44

Δ 45

Δ 46

Δ 47

G. S. File No. 4/68

2640
24636
1774

4-68

0-00
0-00

36
19
36-30
19
230
16-17
8-9
2

557
North
195

25 19.3
107-24

518-6

July 24 72
235

5

5

CS FILE FOLDER

CONTAINS

MORE

INFORMATION