

Sec 13,  
T.27 S. R.6 W.

July 8th 1938

Mr A.S. Coen,  
Coen Lumber Co;  
Roseburg, Ore.

Dear Sir,-

The survey of the Cobb hatchery tract at Edenbower was completed this morning; Mr Walter Edmonds asked me to run out the east line of the property after the west line was run for you, which I did. Permanent points were set at all the four corners.


In running out the west line it was found that the S.W. corner came just six inches from the corner of the building proper, which is used as the garage and service station, the line then ran north from there almost parallel with this building to one of the buildings which make up the camp grounds. The sketch shown below will make this clearer.

The charge to you for running out the west line is \$3.50 a bill is enclosed.

Very truly yours,

Arthur Boyer  
Dep. Co Surveyor,

Roseburg Pacific Highway Winchester →

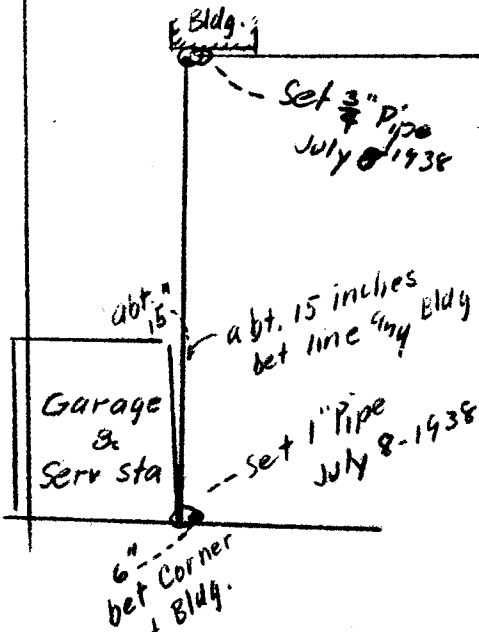

C. S. File No. 4/69

CS FILE FOLDER

CONTAINS

MORE

INFORMATION