

Deed Description, Adams to Rice

Beginning at a point from which the 1/4 corner between section 3 and 10, T 29 S, R 6 W, N.M., bears S 18°38'W 1277.8 feet, thence ~~to~~ N 89°45'E 2200.9 feet to line between sections 2 and 3 at the 1/16 corner thence following on the top of a ridge the following distances and courses, to-wit,

N 77°00'W 194.4 feet,  
N 75°59'W 318.7 feet,  
N 82°07'W 101.6 feet,  
N 82°22'W 307.3 feet,  
S 88°10'W 156.1 feet,  
N 88°09'W 243.4 feet,  
N 84°57'W 146.2 feet,  
N 88°32'W 202.5 feet,  
S 83°08'W 105.4 feet,  
S 48°18'W 183.5 feet,  
S 86°08'W 41.8 feet,  
S 87°02'W 177.8 feet  
S 56°15'W 106.9 feet to the place of beginning containing

6.56 acres more or less.

4/51

6-51

Survey for.

Rice Bros - Adams

Sta	Dist	L A	R A	Needle	e e
-2° 40'	<u>183.5</u> 183 <sup>2</sup>	34° 50'		S 48 <sup>1</sup> / <sub>4</sub> W	S 48°-18' W
Δ <sub>10</sub>	<u>105.4</u>				
-10° 00'	107 <sup>0</sup>	8° 20'		S 83 W	S 83°-08 W
Δ <sub>9</sub>	<u>202.5</u>				
-4° 05'	203 <sup>0</sup>	3° 35'		N 88° W	N 88° 32' W
Δ <sub>8</sub>	<u>146.2</u>				
-2° 30'	146 <sup>3</sup>		3° 12'	N 84 <sup>1</sup> / <sub>2</sub> W	N 84°-57' W
Δ <sub>7</sub>	<u>243.4</u>				
+0° 30'	243 <sup>4</sup>		3° 41'	N 87 <sup>3</sup> / <sub>4</sub> W	N 88°-09' W
Δ <sub>6</sub>	<u>156.1</u>				
-3° 31'	156 <sup>4</sup>	9° 28'		S 88 <sup>1</sup> / <sub>2</sub> W	S 88°-10' W
Δ <sub>5</sub>	<u>307.3</u>				
-18° 45'	324 <sup>5</sup>	0' 15'		N 82 <sup>1</sup> / <sub>4</sub> W	N 82°-22' W
Δ <sub>4</sub>	<u>101.6</u>				
-1° 30'	101 <sup>6</sup>	6° 08'		N 82° W	N 82°-07' W
Δ <sub>3</sub>					
+2° 0'	<u>318.7</u> 318 <sup>9</sup>		1° 01'	N 76° W	N 75°-59' W
Δ <sub>2</sub>					
+13° 30'	<u>194.4</u> 199 <sup>9</sup>			N 77° W	N 77° W
Δ					

Feb. 1, 1928

Wolford

McCabe

Rice

Rice

Adams

Hawk.


C. S. File No. 6/51

① Hub on E. line of Sec 3  
Approx  $\frac{1}{16}$  cor North  
of SE cor of Sec.

Sta Dist L.A R.A N C.C.

⊙ Iron Bolt  
17

0° 00'	9.2 92	26° 33'	S 73 W	S 72° 45' W
Δ 16 -23° 28'	205.1 2242		11° 15'	N 80 1/4 W N 80° 42' W
Δ 15 -13° 45'	152.5 1570		31° 47'	S 89° W S 88° 03' W
Δ 14 -7° 19'	164.3 1656	30° 46'	S 57 W	S 56° 16' W
Δ 13 -25° 25'	177.8 1962		0° 54'	S 87 1/4 W S 87° 02' W
Δ 12 0° 00'	41.8 418		37° 50'	S 86° W S 86° 08' W
Δ 11				

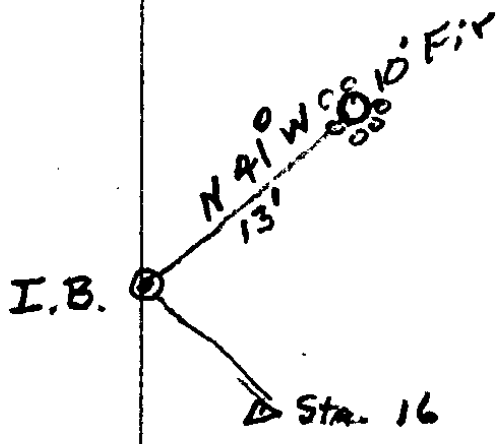

Want location of 14  
on line -

C.S. File No. 6/51

CS FILE FOLDER

CONTAINS

MORE

INFORMATION