

6/5-8


4-58

Block 27

Denn Garrison Lot

Main St.

Bowker } Nov 3/25
Wolford }

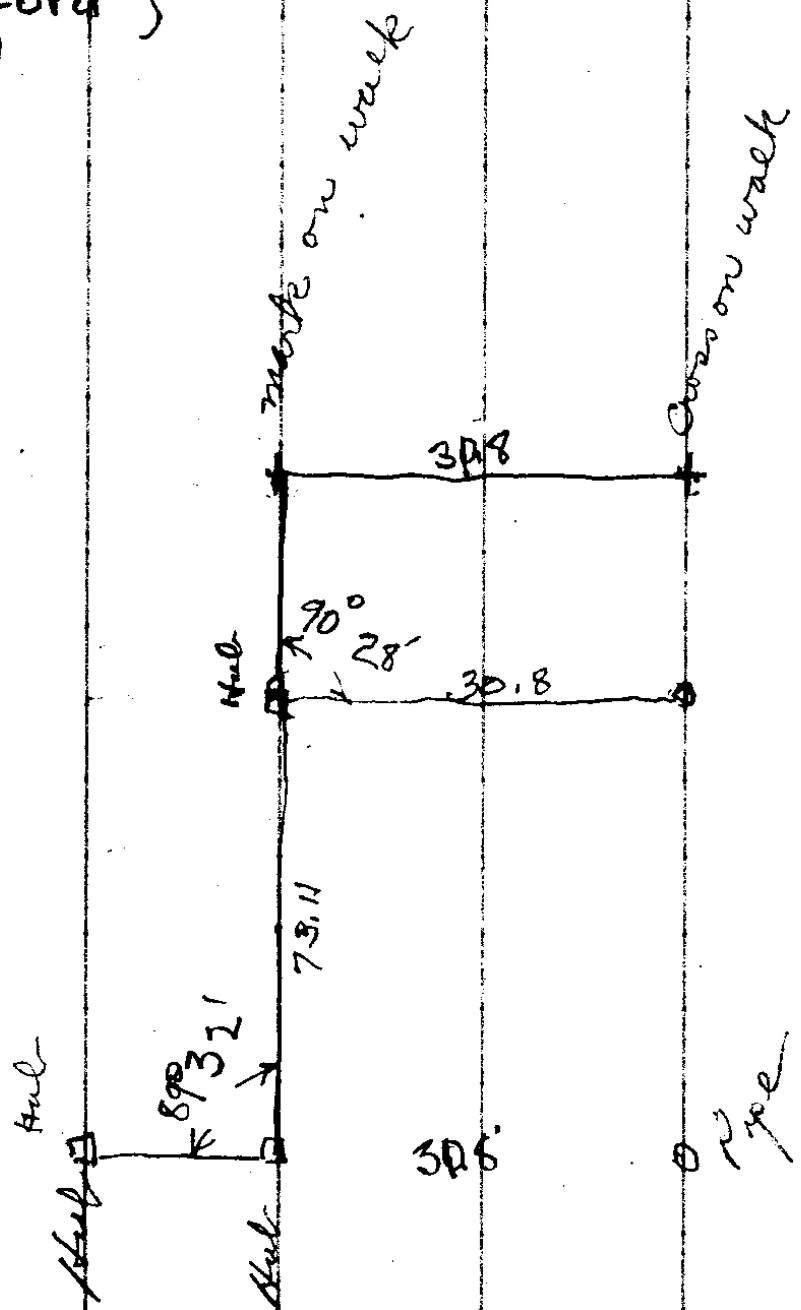


1.37
1.37

89-53
90-04
89-48
90-14
89-59

Stephens
387.53
60
1327.53
86382

85/4
W 6/58

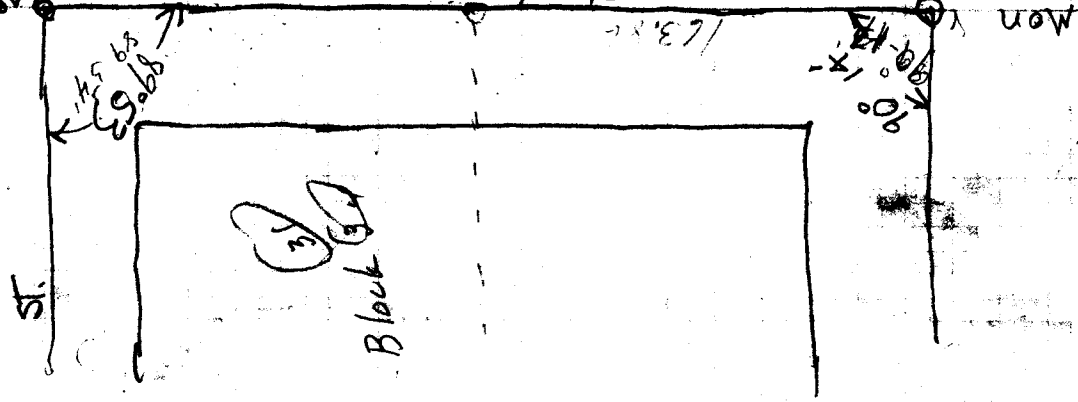


284.5
Washington

3
3
Block 3

112.7

284.2
142.1
Oak St.

22.242
112.2

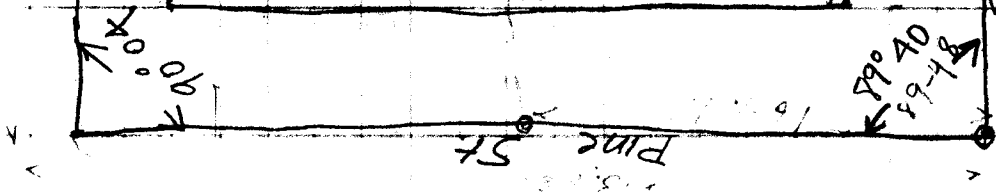

73-12
30-8
30-4
38-20
357
360

19/6
19/6
3.5
2.8
1.0
1.0

Mon

Mill St.

Manu.

Monk.

90°

30'

30'

30'


Block 87
30. Addn.

190.0
30
40.5
40.5
151.5
38.5
<hr/>
192.0

166.9
36.45
203.35
57.65
22
<hr/>
380.00

Burke
a.s. 6/58

38
323
4.17

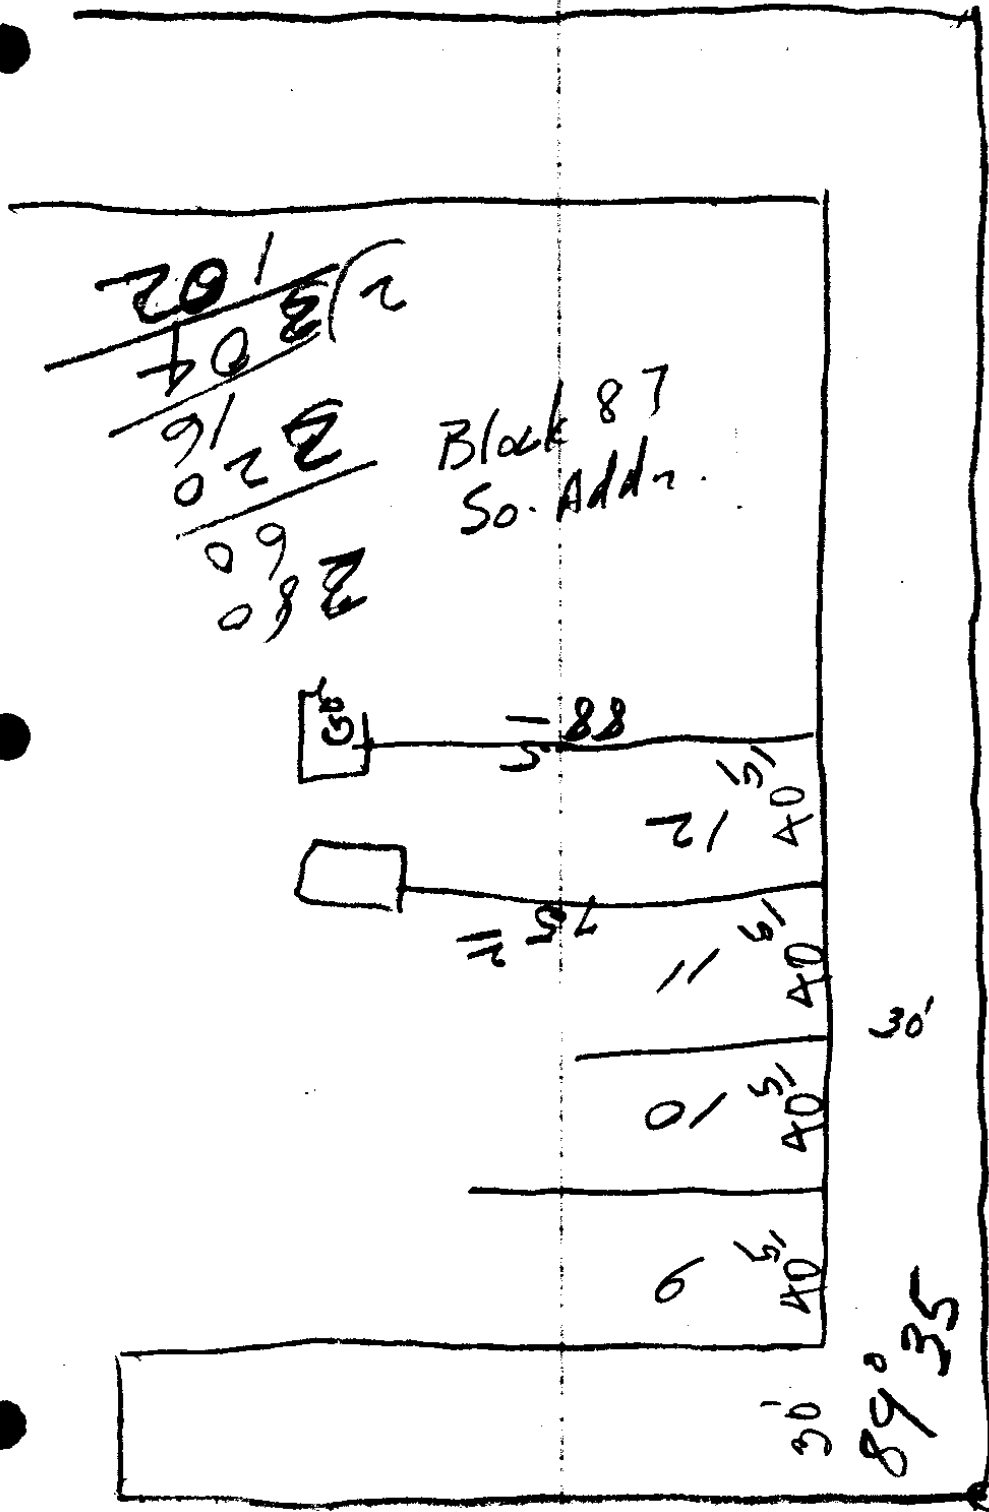

280
60
220
16
2304
102

Block 87
So. Addn.

190
100
93.9
383.9
60
323.9
40.5

Short.

St. 279.9

89° 35'

Balt.

