

7-2B

66 ✓ 165  
32  
330

2.5

Set 18 Turn to 20, please  
Turn 160 or Pt 165 ft  
Bear. N 85° 29 W

C.S. File No.

~~7-2B~~

# Legal Survey.

Chas Leiser, Fernal Briggs

Registered legal Notices having

been sent. I start survey on

Jan 4, 1922, about 3 weeks later than

date set by Notices, agreed to be O.K.

by Leiser & Briggs. G.G. Stewart Dep. C.S.

I began at Cor 34-35

found 2 O.B.T. Drove I.P. For Cor,

Original 18" B.O. S 80° E 40 link

" 12" B.O. S 12° W 38 1/2 ft

24" B.O. North 35 1/2

24" F.I. N 89° E 68 1/2

Corner set in Presence

Chas Leiser

I G Walker

M. Jones

Cor				Var 21°	
1	—	23° 30'	118°	—	N 4° 10' W
2	5° 07' R	2° 30'	144°	N 1° E	N 0° 15' E
3	0	12°	124°		
4	7° 54' R	12°	285°	N 9° E	N 8° 51' E

34

~~180~~

179 60

62 28

---

117° 32'

2

117° 32' L

Mag S 83° W 116° (18° V.A)

108° CL Cor

From #2 I go to S.VV. Cor DL C

126° #62. Find W.O.B.T. original. Set

8" Squared Oak Post Marked CL 62 C.S

20' Mark 8' Fir S 25° E L<sup>2</sup> H

C.S. File No. 708

Chas Leiser

4					N 8° 51' E
	9° 29' L	—	1084 <sup>9</sup>	North	N 0° 38' W
5					
	13° 52' R	2°	297 <sup>2</sup>	N 15° E	N 13° 14' E
6					
	14° 18' L	3°	299 <sup>8</sup>	N 1° E	N 1° 04' W
7					
	0	14°	153 <sup>6</sup>	"	"
8					
	7° 36' L	9° 30'	203 <sup>6</sup>	N 7° W	N 8° 40' W
9					
	2° 35' R	6°	164 <sup>6</sup>	N 5° 40' W	N 6° 05' W
10					
	0° 38' R	4° 30'	227 <sup>5</sup>	N 5° 00' W	N 5° 21' W
11					
	R 14° 17' R	13°	92 <sup>5</sup>	N 10° 30' E	N 8° 50' E
12					
	2° 52' L	8° 30'	67 <sup>-</sup>	N 6° 30' E	N 5° 58' E
13					
	0	20°	226 <sup>4</sup>	N 9° E	"
14					
	4° 36' R	12°	213 <sup>9</sup>	N 12° E	N 10° 34' E
15					
	11° 16' L	6° 30'	268 <sup>8</sup>	N 0° 30' E	N 0° 42' W

1849

~~118.0~~

10849

# 5 on Bridge

108.2

2970

144.8

2994

400.8

1084.9

1490

297.0

299.4

200

149.0

200.8

2664.9

No 1/4 cor Found.

All B.Ts down & Lost

1636

2266

902

664  
Wire Fence?

2190

2089

2670

C. S. File No.

7/20

Chas Leiser

X 0° 42' W

16	2° 34' R	0	654 <sup>8</sup>	N 2° 30' E	N 1° 52' E ●
17	0° 04' R	4°	259 <sup>3</sup>	N 2° 30' E	N 1° 56' E
18	76° 31' R	—	239 <sup>5</sup>	N 79° E	N 78° 27' E ✓
20 18 TO A	80° R	—	149 <sup>7</sup>	To possible Cor. Cl. 62	N 78° 04' W
18 TO C.	96° 20' L		243 <sup>0</sup>	To poss. Cor. Cl. 62	N 85° 36' W ●
18					
19	—	—	446 <sup>8</sup>	—	N 1° 12' W
19	3° 25' R	—	9 <sup>7</sup>		N 29° 28' W N 26° 03' W ✓
Corner as set					



Chas Holden 30-5

G. Stewart Deputy.

Jan 6 1924

Start at Cor 14-15 - 22-23

No Field Notes for Cor. Find 3 Orig B.T.s

Set stK in for Cor By eye and Tie into B.T.s.

	16" B.O.	S 56° 40' E	33 <sup>2</sup>	Tie to Witness Trees.
	12" B.O.	N 52° E	23 <sup>E</sup>	
stK		-	85 <sup>±</sup>	S 48° 10' W N 49° 08' E
1.	46' 54 L	-	761 <sup>0</sup>	S 1° 30' W N 2° 14' E
2	81° 42' R	1 <sup>30</sup>	276 <sup>3</sup>	S 84° 30' W N 83° 06' E
3	1° 12' R	7 <sup>30</sup>	62 <sup>4</sup>	S 85° W N 85° 08' E
4	90° 33' L	-	318 <sup>2</sup>	S 7° E N 4° 19' W
5	3° 10' R	-	461 <sup>2</sup>	S 4° 30' E N 1° 09' W
6	0	1 <sup>0</sup>	162 <sup>±</sup>	N 1° 09' W
7	0	7 <sup>0</sup>	300 <sup>0</sup>	S 2° 15' E
8		0	300 <sup>0</sup>	
9		0	300 <sup>0</sup>	S 3° 00' E

7960  
 38 19  
 141

130 a

# Govt Field Notes

links = FT

B. O"	12" S 80° E	123	120 <sup>2</sup>
"	12" N 82° E	163	107 <sup>5</sup>
"	10" S 3° W	156	103 <sup>2</sup>
"	10" N 70° W	70	46 <sup>2</sup>

Briggs ran 10ch from 16-15-22-23 to pt from  
 which Fir 10° N 37½° W 36 links

85<sup>d</sup>



76<sup>o</sup>

From st K.

(515 ft) N 49° 08' E

276<sup>3</sup>

141' 51" L - 78<sup>5</sup> links - S 87° 17' W

To Cor. as set

(S 87° W May.)

359<sup>8</sup>

318<sup>2</sup>

4619 ✓  
 299 2  
 162 1  
 297 2  
 600 5  
 920 2  
 427 2  
 212  
 31495

C. S. File No.

7/20

# Chas Weisen 30-5

9					
	0	-	427 <sup>7</sup>	S 0° 50' E	N 1° 09' W ●
10	25° 03' L	70°	227 <sup>0</sup>	S 25° E	N 27° 12' W
To / Pile Cor. / Balls		0	823 <sup>5</sup>		
* Cor.					
	2° 16' L			S 28° E	N 49° 28' W
20 across river				<del>28° E</del>	
From Sec. Cor		Continued	West		N 27° 12' W ●
	116° 53' R	-	1316 <sup>0</sup> 1413 <sup>0</sup>	N 88° 30' W	S 89° 41' W
1	51° 01' R	0	284 <sup>0</sup> 224 <sup>2</sup>	N 34' W	N 39° 18' W
2	38° 40' L		1022 <sup>7</sup>	N 87° W	N 77° 58' W
3	7° 25' L		599 <sup>0</sup>	N 86° 30' W	N 85° 28' W
4	23° 02' R		1624 <sup>4</sup>	N 62° W	N 62° 21' W ●
5	23° 19' L		556 <sup>0</sup>	N 84° 30' W	N 85° 40' W
6					

Setting Cor 14-15-22-23  
B.Ts Found + Field Notes

3149<sup>±</sup>

Do Not agree. Start  
at a point S 37°30' E, 36 links

1049<sup>±</sup>

of a Fir Tree set by Briggs  
run West, Var. 20°30' E, 10 ch.

Set I.P.

N W 0 6"	N 70° W	49 <sup>±</sup> link
W 0 8"	S 16° E	80 "
W 0 6"	S 24° W	131 <sup>±</sup>
B 0 10"	N 83° E	149 <sup>±</sup>

Set in Presence Clem L. Davis, Chas Leiser  
J. G. Banker, Perle Davis  
Edge river + End fence

2 edge load.

From Cor. as est. I note

Orig B.T. N 25° W, 18" B.O

" " S 80° E 12" B.O

107  
97  
58  
58

Road and Bridge

C. S. File No.

7/28

To. - 21-22-27-28 Cor.

Chas Leiser

6

83°00 L

698<sup>6</sup>

N 85° 40' W

S 11° 20' W

7

14° 22' L

2°

300  
386<sup>9</sup>

S 2° 40' E

S 3° 02' E

8

B.T.

43° 03' R

154<sup>2</sup>

S 40° 30' W

+ To Cor.

45° 13' L

47<sup>9</sup>

S 47° E

S 48° 15' E

1 27-28 as established by C.S.

Cor is at end of Con. Iron Culvert  
at Cross roads

Setting of Cor. Set.

22-23

27-26

Moved Pile of rocks as set by Germond for  
Cor. North 8<sup>ft</sup> West 3<sup>ft</sup>. Set I. Bar  
for Cor. Marked trees as follows

16" Pine N 60° W 52<sup>8</sup>

Rock Mon. N 24° E 103<sup>0</sup>

8" Pine S 13° E 57<sup>2</sup>

10" Fir S 76° W 115<sup>8</sup>

Witness Chas Leiser, J.G. Barker

Miles Jones,

Jan 7-1922

203  
97

200  
197  
103

Is a 8" W.D. in SW quadrant

1" x 3" (Ford axle)

C. S. File No.

9/28

Set at Sec Cor 22-23-26-27 as  
est. Run on bearing of Sec. line  
as Estab. Mag.

90° R

520°

N 0° 15' E

North —

1128<sup>6</sup>

East

Pit in I.P. "x 4' from which  
a 30" B.O. bears N 78° E 127<sup>5</sup> ft

Marked R.P.C.S

A 18" Ash S 5° W

Marked R.P.C.S. 76° ft

This is 17.10 chains East of  
Sec line between 22-23 and run at  
rt angles to line between 22-23  
as determined. Point is 7<sup>88</sup> ch

North of Sec. Cor 22-23-26-27 (From  
deed record)

Set. Chas Leiser, Errol Briggs, J. G.  
Walker Witness

520  
467  
53

- Set Iron Pipe <sup>256</sup> on Cor. To be  
Intersection Claim (Fullerton)  
at Sec line bet. 22-23. and 788 ft  
North of Sec. Cor.

A. 24" B.O. Bears S72°W 173<sup>5</sup> ft  
Chas Leiser, Errol Briggs, J.G. Walker  
Witnesses

---

Set NW Cor D.L.C # 62 as foll  
Set on # 18 B. 5" 20 Tur an angle  
16° 04' R 165° N 85° 29' W

Set I.P. for Cor on Edge So. Imp.  
a 18" Fir S83° E 699 links


18" B O S 46° 30' E 125 links

Chas Leiser, J.G. Barker, Witness

Jan 7-22

C.S. File No.

7/28

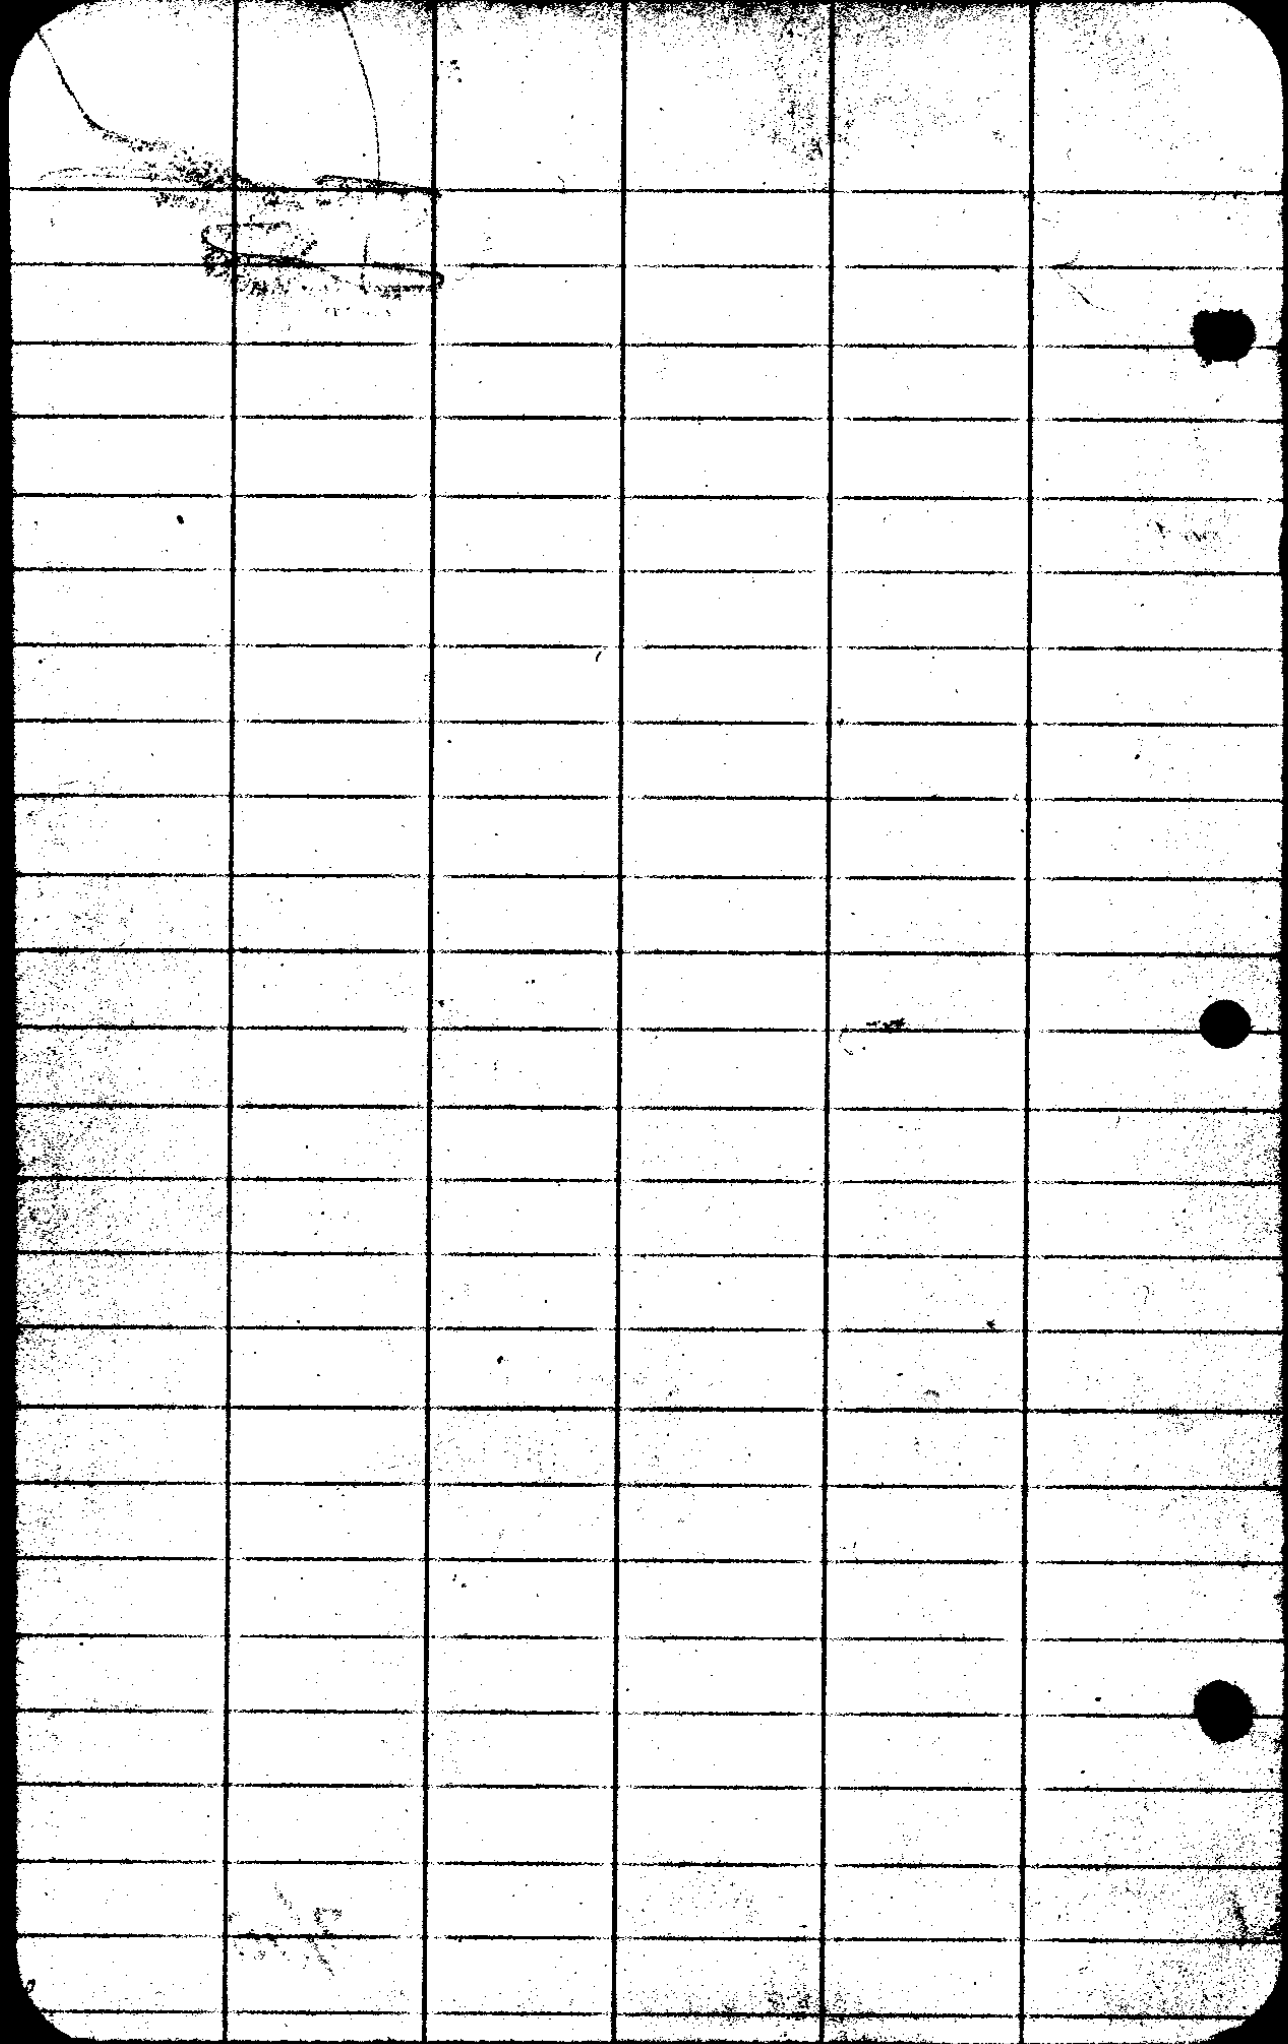

CS FILE FOLDER

CONTAINS

MORE

INFORMATION