


Cor. No.	Description
1	6"x50" Fir Post set 2 ft. in ground & marked
2	8"x50" " " " 2. " " "
3	6"x50" " " " 2. " " "
4	12" Square Fir stump 5 ft. high & marked
5	6"x60" Madrone Post set 2 ft. in ground & marked
6	6"x50" Ewe " " " " " "
7	5"x50" Fir " " " " " "

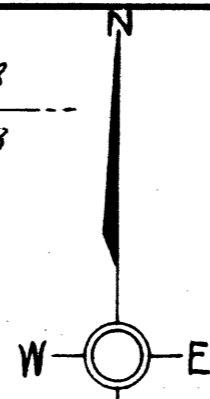

Scale 1 in. = 500 ft.

32

MAP OF
THE DORE MINING CLAIM

IN
 SEC. 32 - T. 30 S. - R. 4 W. - Will. Meridian.
 Douglas Co. - Oregon.

Surveyed for F. T. Reynolds, by F. C. Frear Dep. Co. Surv.
 Office of M. B. Germond Co. Surv.
 Nov. 1918

Bearings given are true Sun Bearings
 Variation of Needle = 20°-20' E.