


MAP OF W.E. ST JOHN RANCH

IN
SECS 3 & 10 - T.30S. - R.4W. - W.M.
Douglas Co., Oregon.

Office of M.B. Germond Co. Surv.
Dec. 1918

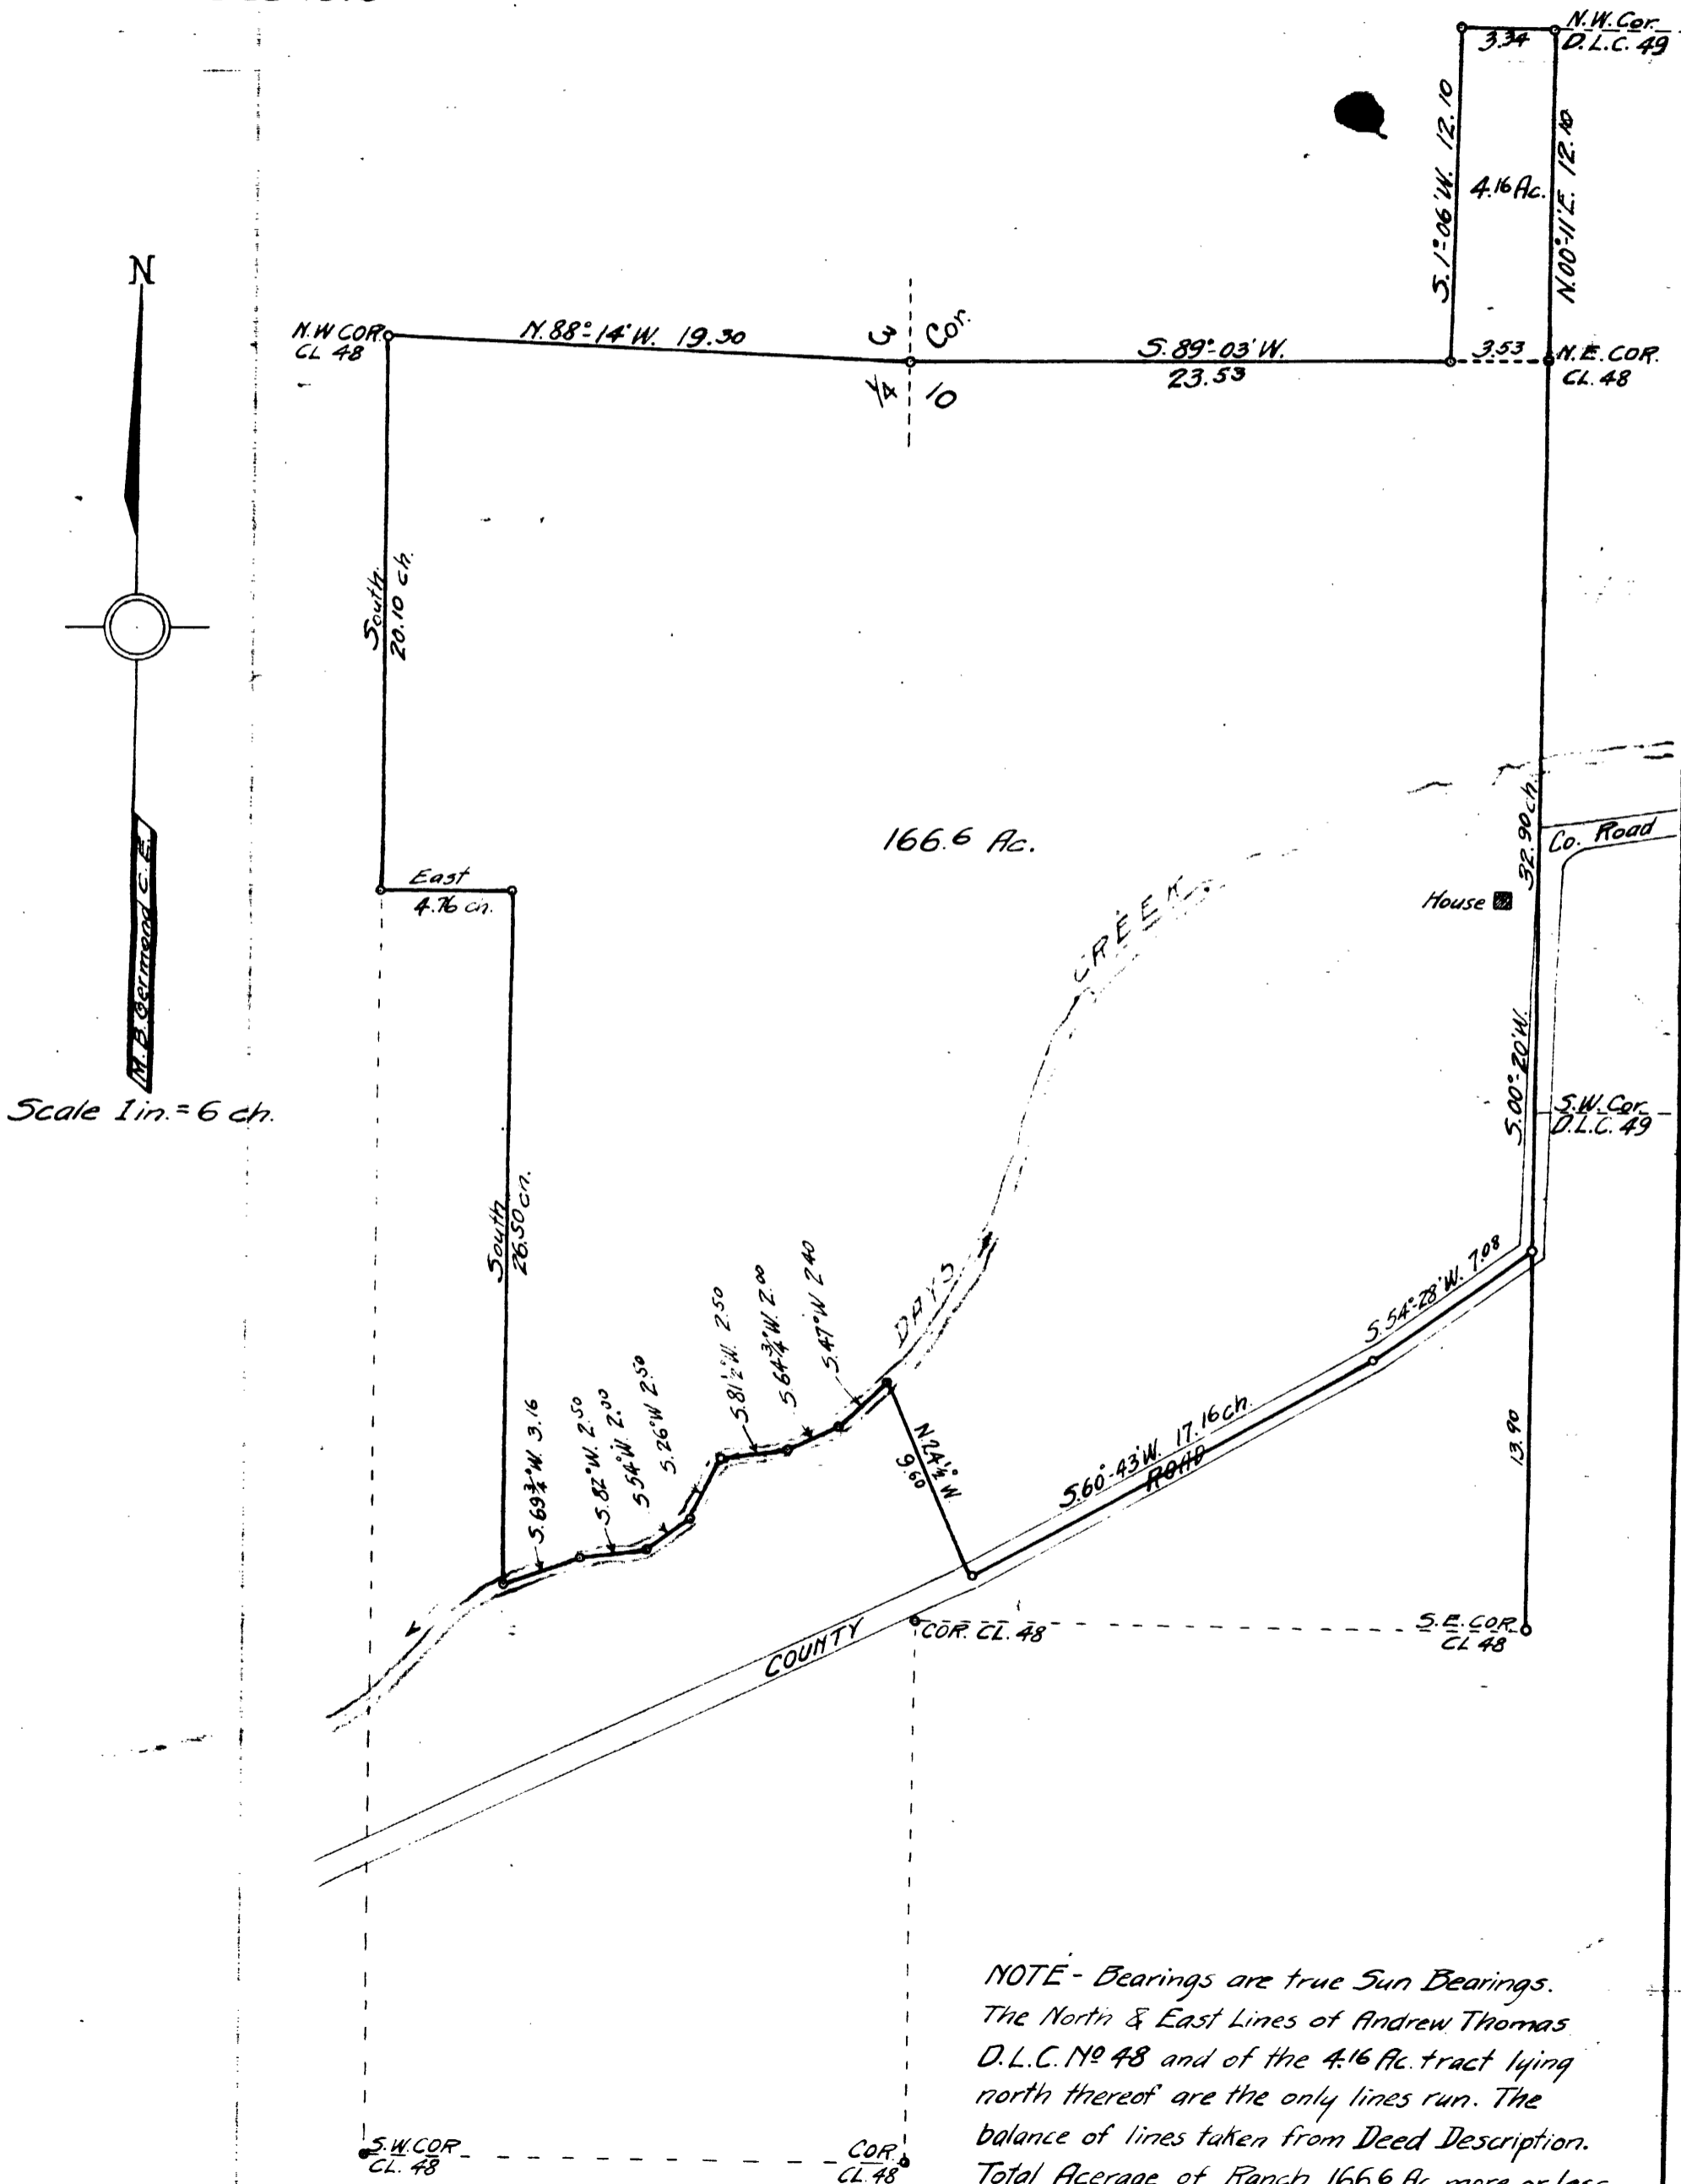

NOTE - Bearings are true Sun Bearings.
The North & East Lines of Andrew Thomas
D.L.C. No 48 and of the 4.16 Ac. tract lying
north thereof are the only lines run. The
balance of lines taken from Deed Description.
Total Acreage of Ranch 166.6 Ac. more or less.