

MAP OF
FISH COMMISSION WATER FILING


SEC. 36 T 255 R 3 W W.M.
 SEC. 31 T 255 R 2 W W.M.

CERTIFICATE OF REGISTERED PROFESSIONAL ENGR.

I, H.L. Eppstein, of Roseburg Oregon, do hereby certify that this map was made from notes taken during an actual survey under my immediate supervision in December 1928 and that it represents the work described in the accompanying application, together with the streams and other ditches in the immediate vicinity.

Oregon License No. 1011
 Date of Registration Nov. 8, 1920.

Registered Professional Engr.

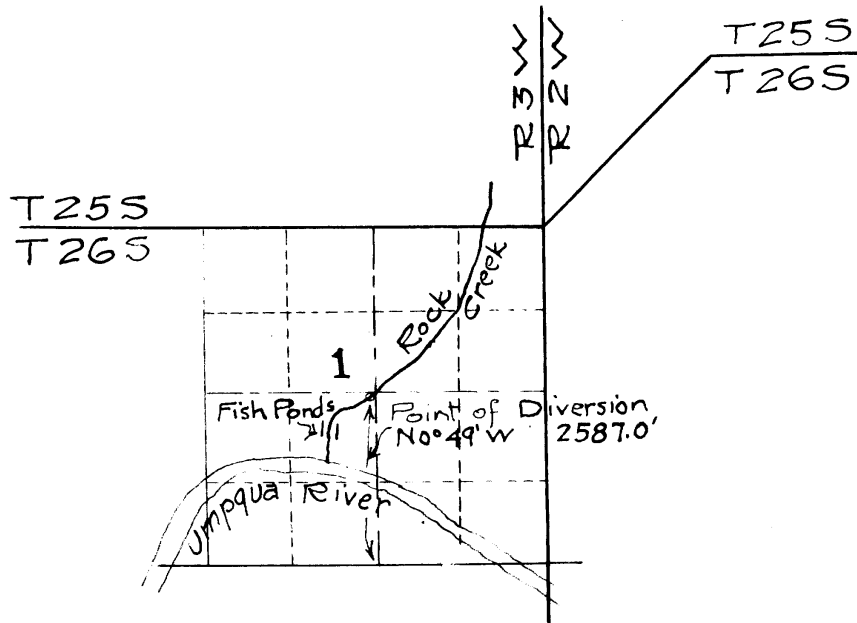

MAP OF
 FISH COMMISSION ROCK CREEK
 WATER FILING

Sec. 1 T265 R3W. W.M.
 Douglas County Oregon

CERTIFICATE OF REGISTERED PROFESSIONAL ENGR.

I, H.L. Epstein of Roseburg Oregon, do hereby certify that this map was made from notes taken during an actual survey under my immediate supervision in December 1928 and that it represents the work described in the accompanying application together with the streams and other ditches in the immediate vicinity.

Oregon License No. 1011
 Date of Registration Nov. 8, 1920.

Registered Professional Engr.

CS FILE FOLDER

CONTAINS

MORE

INFORMATION