

Fair Warr

Along Side Side Plat 1
Dufferin Drigate

June 25 / 23

● Hub #0 is Iron Pipe

W Cole
H E Richardson
Bundy
Kindred

N S 24

#1 Fence. 1' Right.

0.5

0.2

● 0.6

2.4

2.1

51.7

#7 = Post. 1320 North of Sec Cor
532

● Old lot stake about 18 ft ahead

of #8

N 1'

1 1/2'

Platted Road

~~#10~~

N 89° 26 W

10

126 19
R 63° 09'

N 25° 15 W N 26° 17 W

920

11

25° 46'
L 12° 52'

N 38° 30 W N 39° 09 W

2112

12

57 23
R 28° 41'

N 10° 30 W N 10° 28 W

3000

804

13

R 6° 02'

N 4° 50 W N 4° 26 W

7579

#

14

R 2° 23'

N 2° 00 W

3094

15

R 1° 06'

N 1° 00 W

10' □


85
85
57

□ 10' ○

B7 } - □ 17° , ○
76 }

B5 } □ 10' ○
77 }



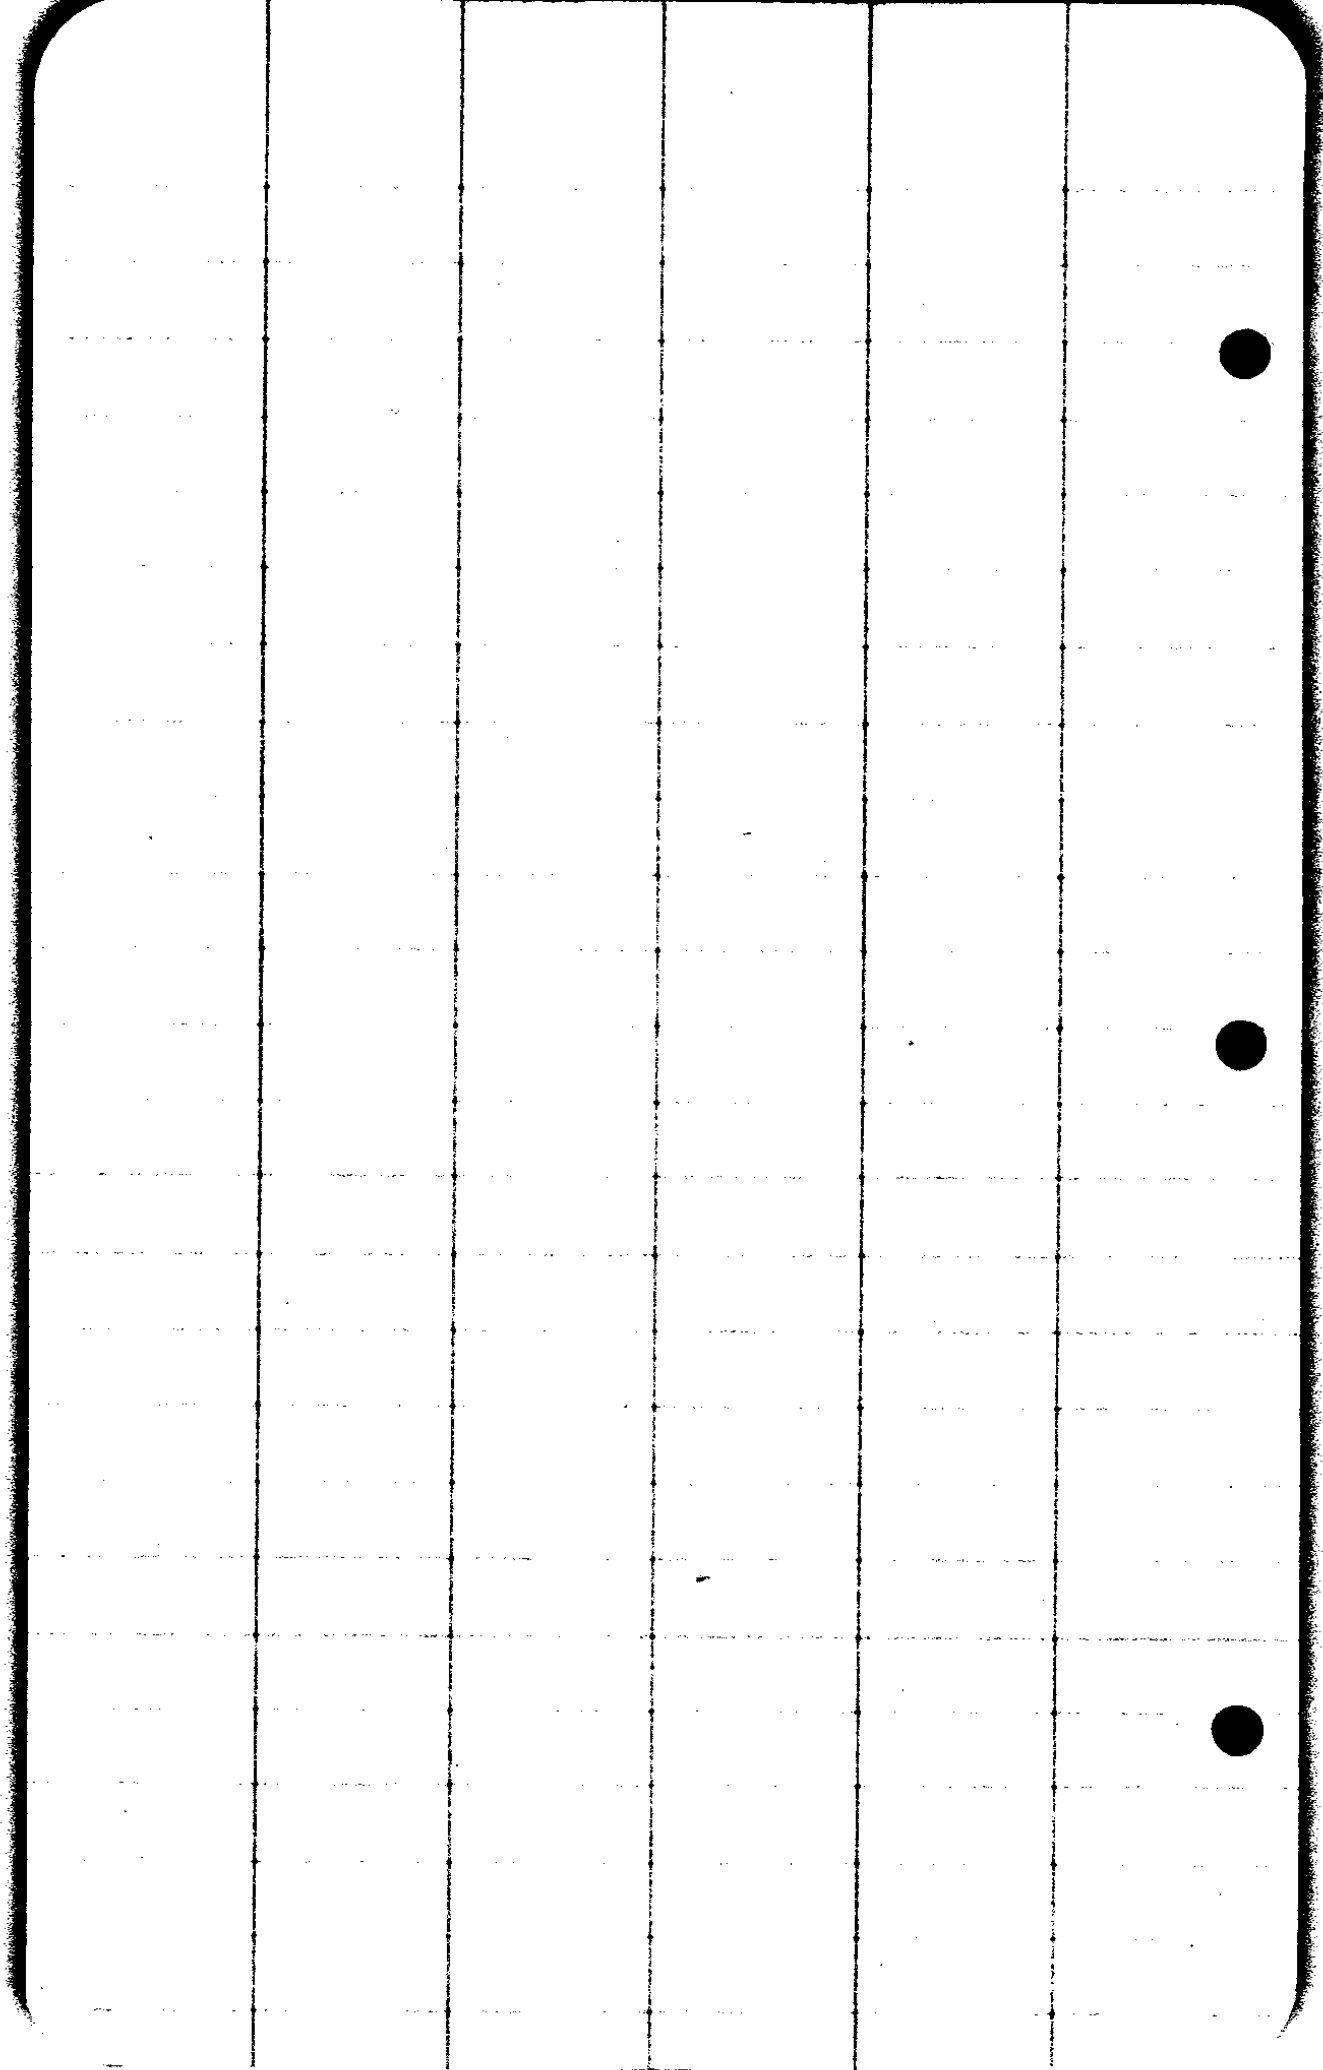

14-4

14-4

Survey for Pinder + Kindred 925 SR 5W.

0.		589°45W 589°45W	-8°30' 300° -16°30' 454	2967 <u>435</u> 3402
3462 # 1.	1°12' R0°36'		-6°00' 902	897
4299 # 2.	0°39' L0°19'	N89°50W N89°39W	-3°00' 2514	2517
6812 # 3.	0°21' R0°10'	N89°58W	-14°20' 1871	1812
8622 # 4.	0°43' R0°21'	N89°48W	-16°00' 2480	2384
11006 # 5.	0°15' R0°08'	N89°27W	-17°06' 1752	1674
12680 # 6.	2°49' R1°25'	N89°19W	-10° 1360	1340
14627 # 7.	0°02' R0°01'	589°16W N88°04W	-5°30' 2446	2434
16454 # 8.	2°12' R1°06'	589°15W 589°17W	-12°50' 1556	1517
17971 # 9.	0°22' R0°11'	N89°50W N89°37W	-20°30' 1224	1147
19118 # 10.		N89°45' N89°26W		

