

Marion Hixon

M/24

Hub	Dist	Lat - Long	M.C.	Slope
	156 ^L	41 44 20° 52' R	N 22° 30' E	N 20° 30' E + 310' 156 ³
11	307 ³		N 1° 38' E	N 1 3/4 E - 530' 300 ⁸⁷
2039 ^E	122 ^L	103 0° 32' L	N 2° 10' E	N 3° E - 7° 45' 123 ⁸
9	212 ^L	1 26 0° 53' L	N 3° 3' E	N 3° E - 4° 50' 213 ^E
1703 ^E	87 ^o	9 30 4° 45' R	N 1° 42' W	N 1 3/4 W + 7° 10' 87 ⁸
1616 ^E	234 ^L	2 26 1° 13' L	N 0° 29' W	N 1/2 W + 5 1/2 235 ^E
6	46 ^L	15 41 7 52 L	N 7° 23' E	N 7 1/4 E 29° 30' 53 ^L
1326 ^R	141 ⁹¹	11 56 5° 58' R	N 1° 25' E	N 1 1/4 E
4	188 ^E	8 44 4° 32' R	N 2° 51' W	N 2 1/2 W 40' 189 ³
3	377 ^o	8 34 1° 46' L	N 1° 11' W	N 1 1/2 W - 570' 78 - 300 ^o
2	332 ^L	4 50 2° 26' R	N 3° 37' W	N 3 1/2 W 250' 320 ^o
1	295 ⁷	13 06 0° 53' P	N 10° 30' W	N 10 1/2 W + 85' 299 [±]

1/2 on Com
at [unclear]

1/2 on 210^E

Lain
Apr. 30, 1928

Irving T
Jack Wolford Wc,
Hixson EC,

Mads " Apr
Bud " May

99847

~~99549~~
298 12
87
357 3

~~99097~~
1238
2770

99297

~~99221~~
198 17
490 97
2268 2086

99644

~~99644~~
2135

99106

~~998220~~
298 93 2
996 24
199 48 8
273 739 9 40

99240

~~99847~~
1563 6

99106
898

~~992848~~
492 21 42
792 84 9
990150 68

99036

~~299541~~
549 08 2
499 23 5
798 47

870 36

~~1560608 61~~

99540

~~23 52~~
199 08
497 70

~~699 25 2~~
261 09
435 18 0
447 38 3 2
996 24
1092

99644

~~298 6 2~~
199 0 8

~~199 28 8~~
896 99 6
797 1 5 2
996 4 4
188 5 2 8 44 8

99847

~~299 5 4 1~~

23 4 1 8 0 8

99776

~~299 3 2 8~~
8 2 8

10 30
6 53

29 9 2

98880

23 2 1

3 37

~~38 9 4~~
29 9 2

890 9 8

890 9 8
19 7 7 2

29 5 8 4 8 9 6

Anchor as recorded

1472

12

8.14
4.7 E

✓
N 26° 37' E

72° 30'

N 30 1/2° E - 6° 36' 448 2

1441

SE Cor. C1 #48 T275 R9 W.

Identified location by Dist from NE Cor. C1 #48
and bearing + Dist from old cut now down
and stump out but position plain. Checks
for D.B.T. Axe marks of proper age visible but
no marks.

14' WD N 62 1/2° E 90 ± ft

20' WD S 35° E 70 ±

May 7 1928

99357
1482
198714
794856
397428
99357

147247074


C. S. File No. 14/21

Set up on line line opp ... on line.


	A.	H.A.	M.C.	Time.
1	46° 1'	65° 30' S	64° 5' E	9:30 AM.
2	46° 32'	64° 41' S	65° 20' E	9:33 1/4
3	46° 46'	64° 15' S	63° 00' E	9:35
4	47° 02'	63° 51' S	62° 34' E	9:36 1/4
5	47° 11'	63° 35' S	63° 34' E	9:37 1/2

101

Friday Day
May 3 1928
Some Crew

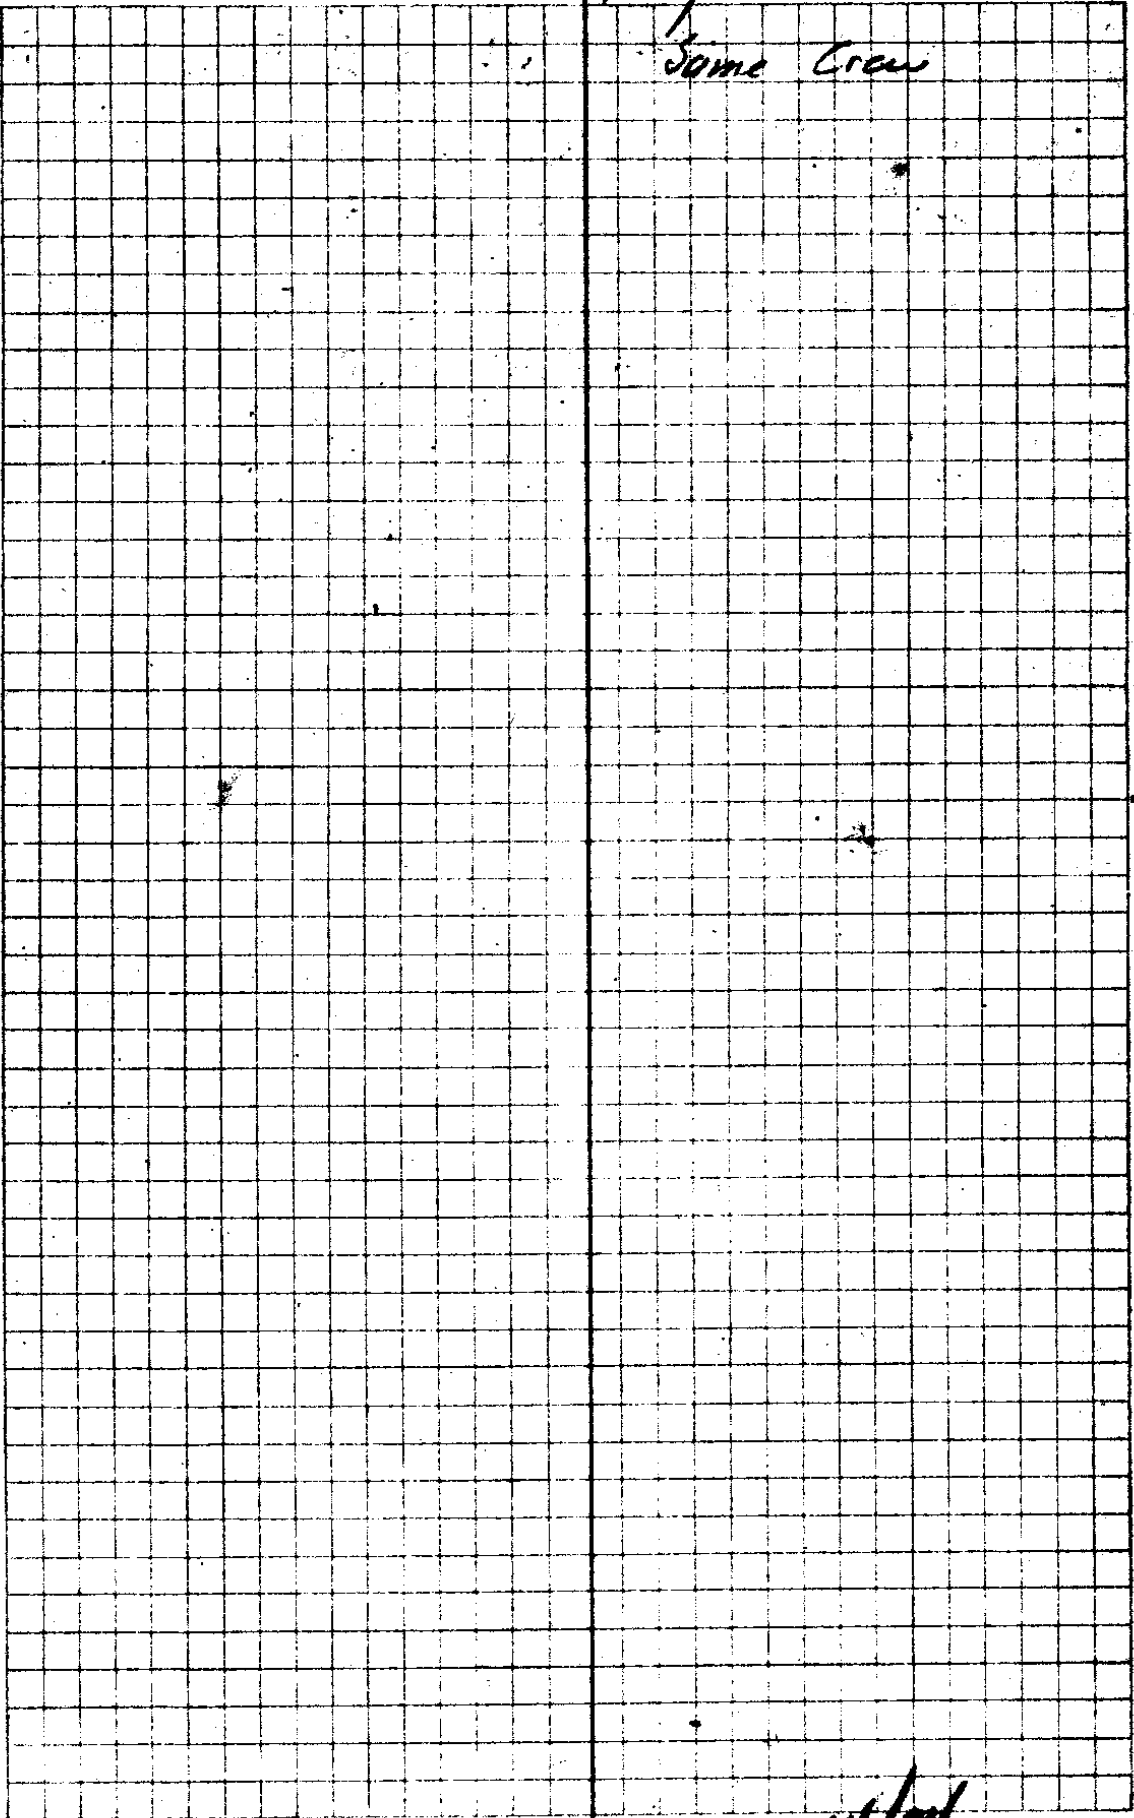

C. S. File No. 14/24

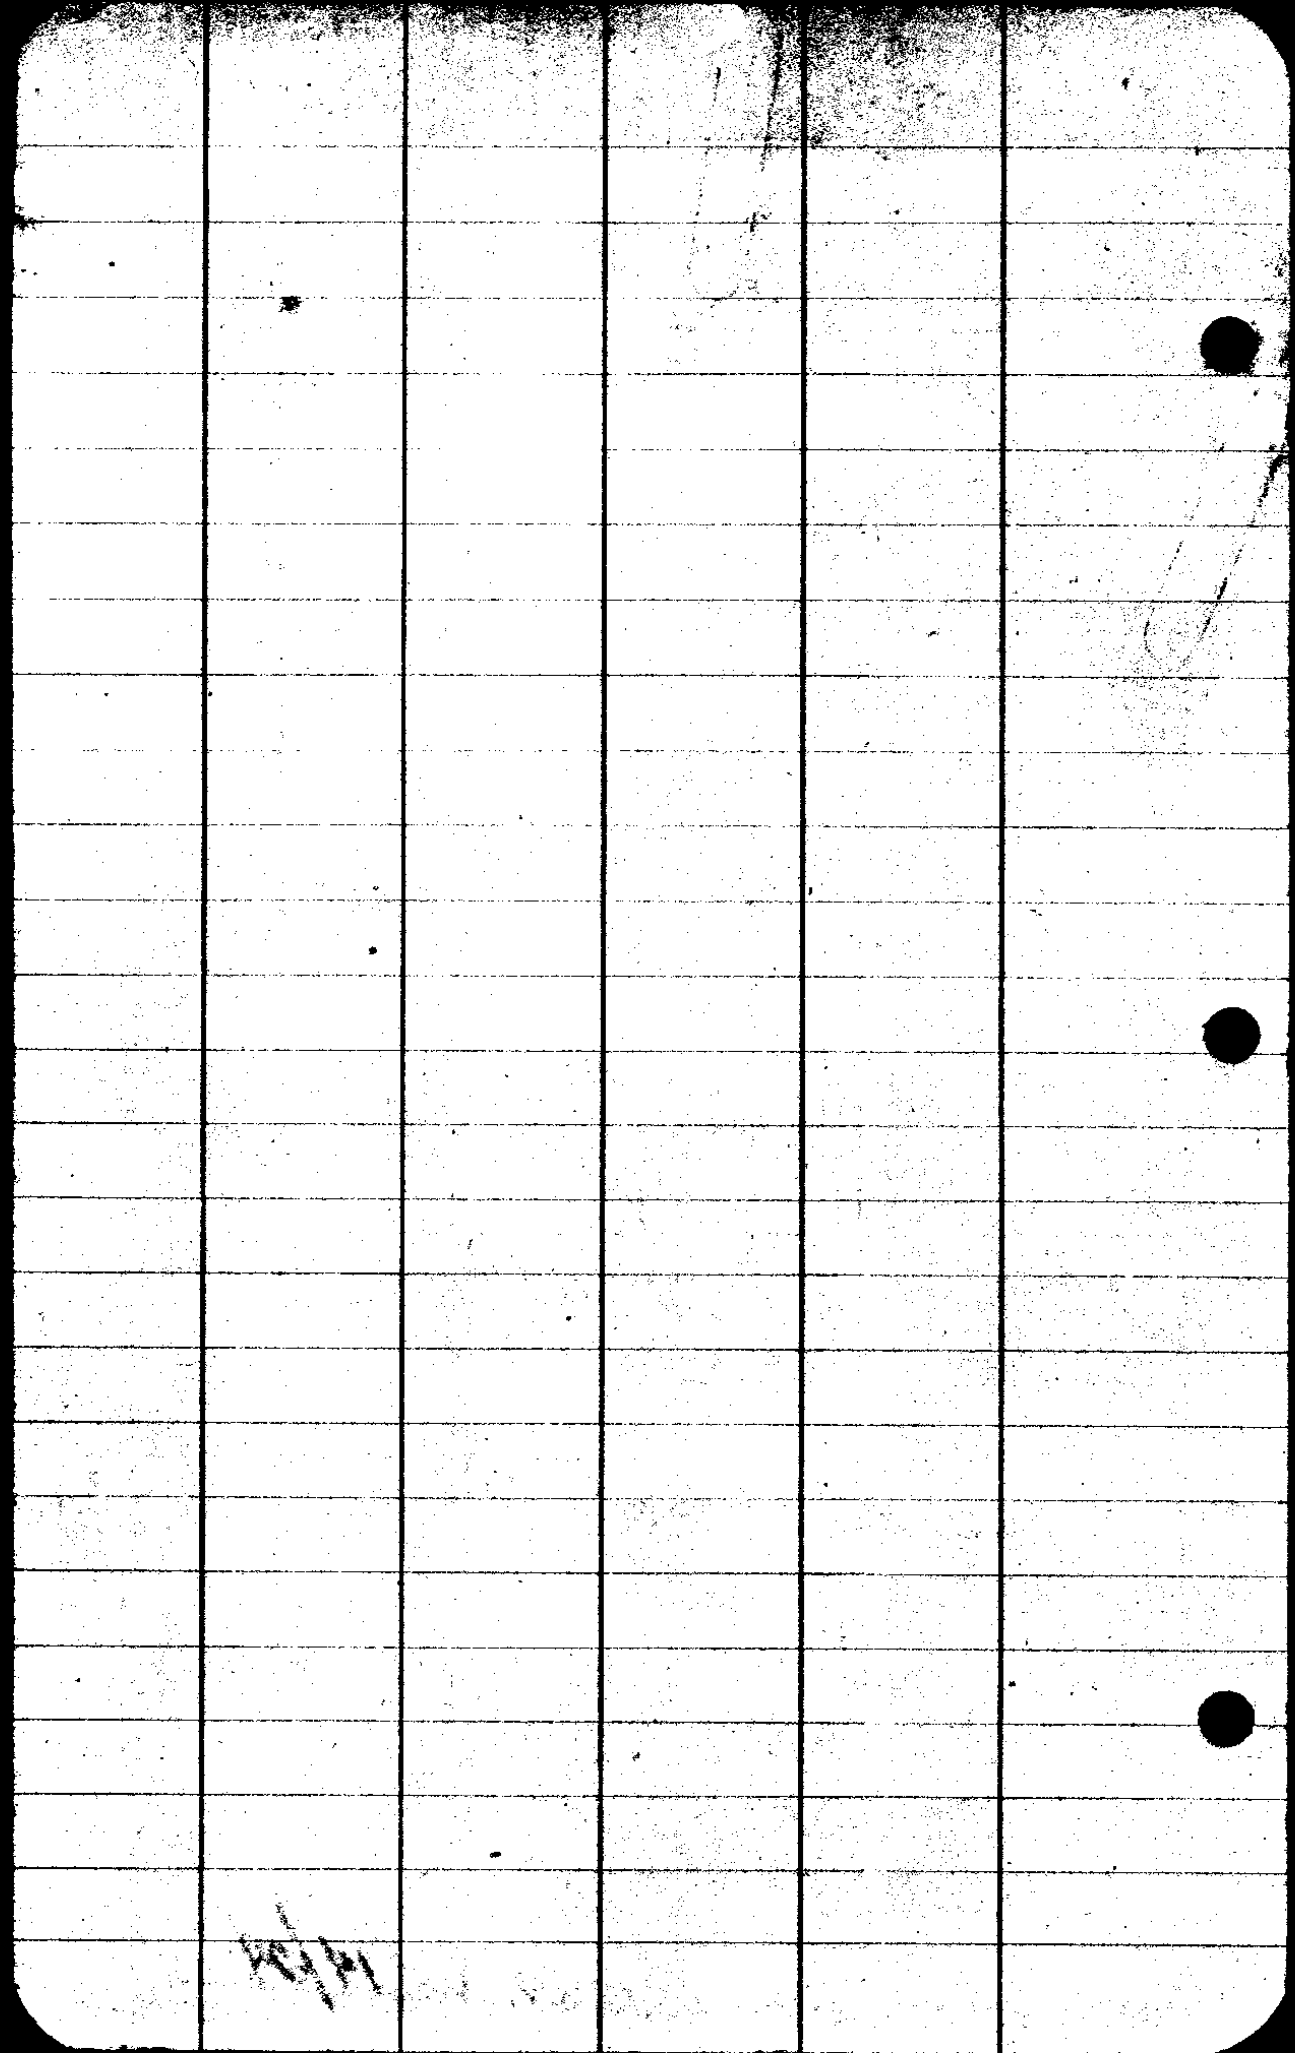

CS FILE FOLDER

CONTAINS

MORE

INFORMATION