


Survey for A.S. Coen

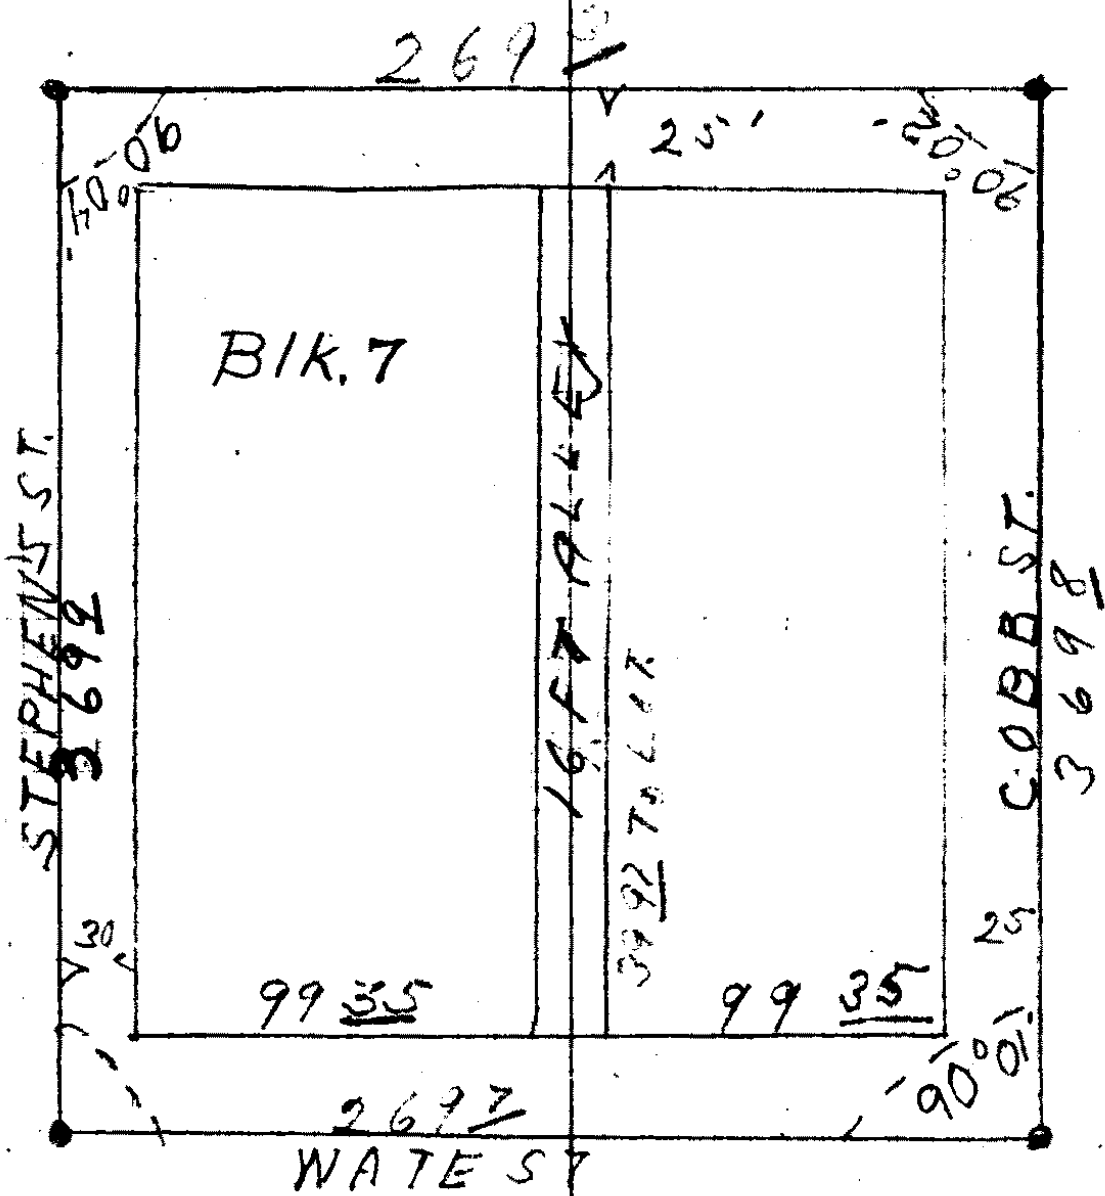


BLOCK 7 & 41

Mar 24, 1931
A. Boyer
H. Epstein
J. Richardson

RD Coen Survey

Block 41

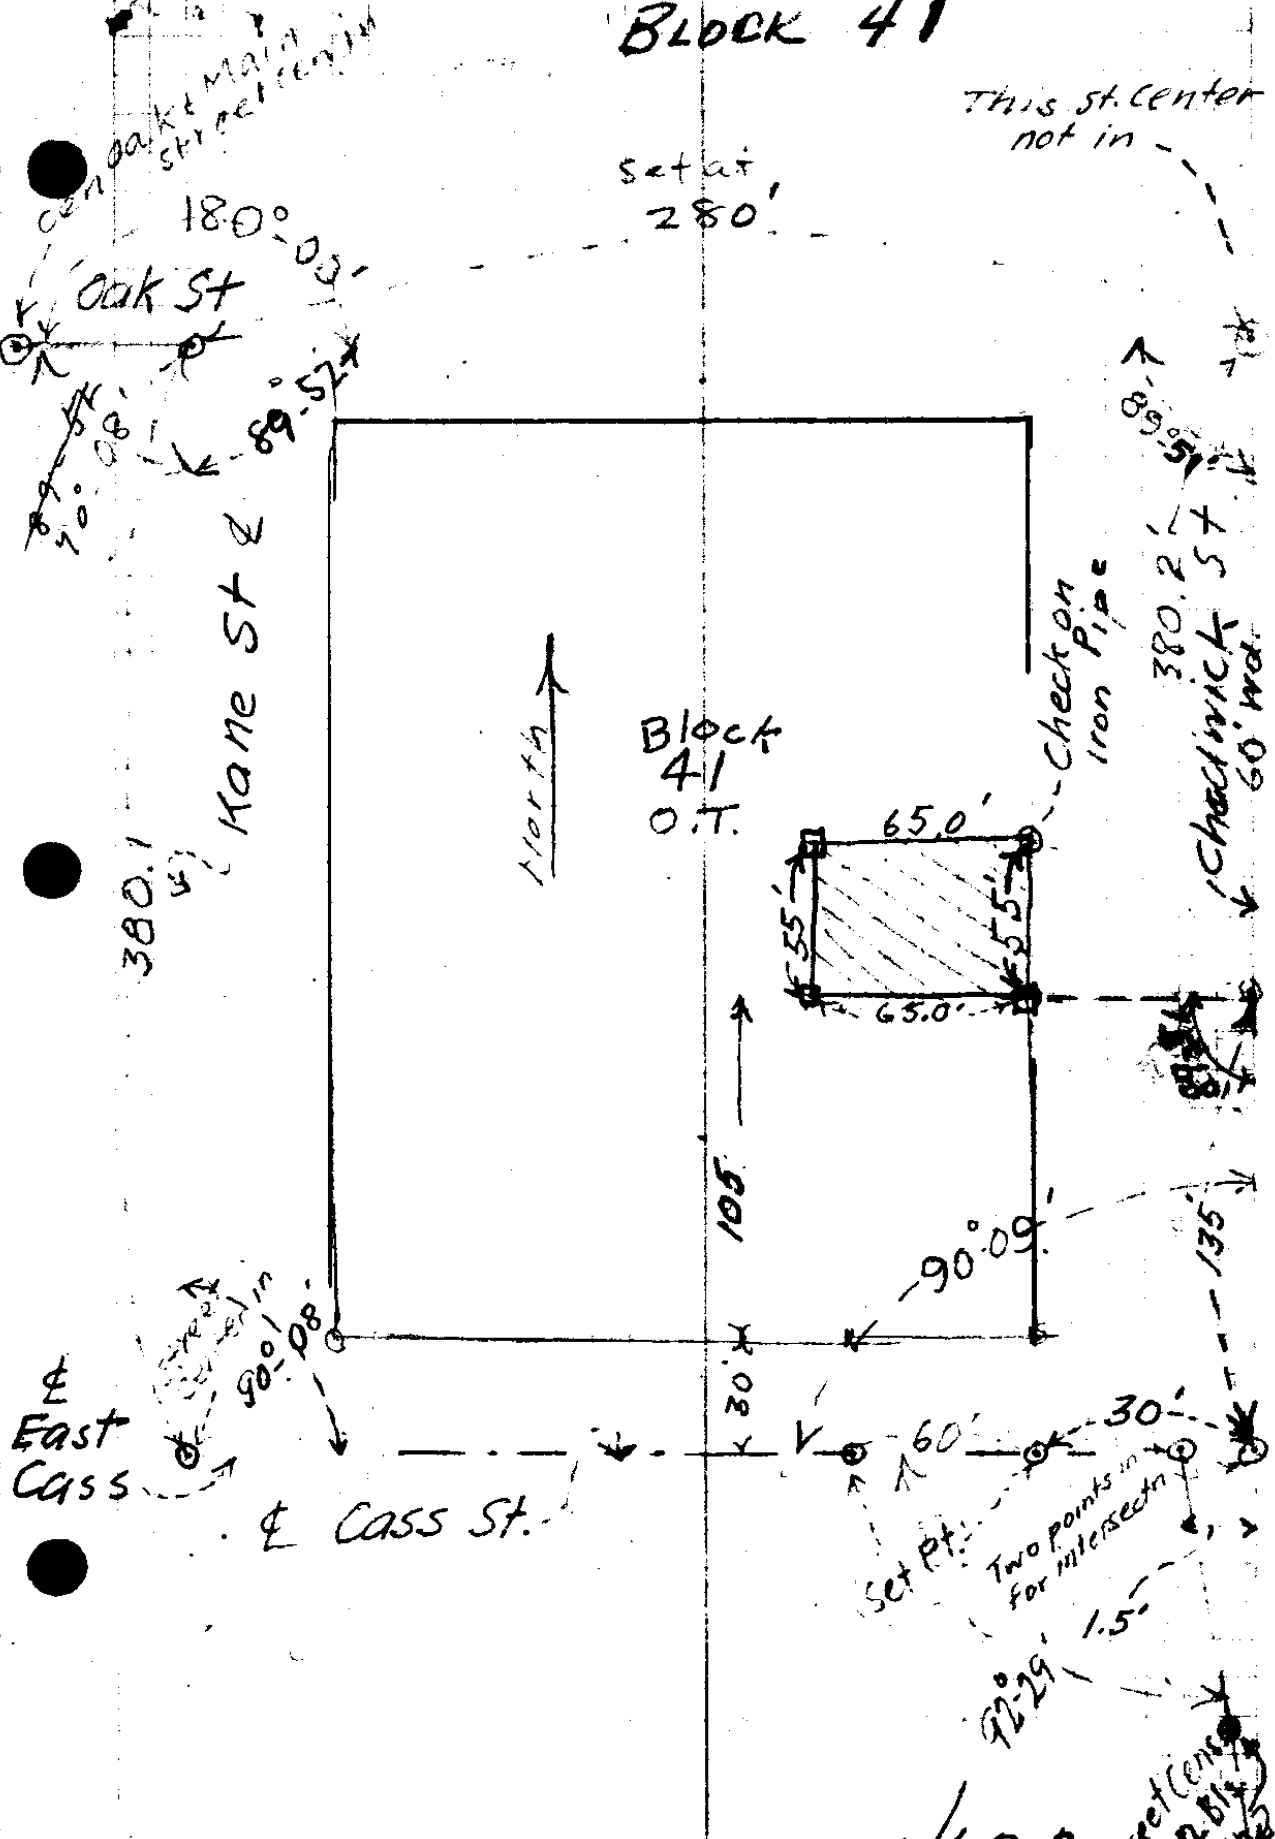

P.C.S. File No. 14/62-2 Street Cens. 18 2 Bl. South