

~~Vir. Hor. Time MC.~~

5

Full 31.2 West of True Corner

Δ5 corner

2813

Δ4

139¹/₂

23¹/₂ ft East

Δ3

261⁰/₂

19¹/₂ " East

Δ2

151¹/₂

12¹/₂ " East

Δ1

305⁶/₁₆

8¹/₂ " "

North

S.E. CW


N

JUNE 7 & 8 1937

15-4

(2)

Eppstein
Richardson
Bellino
Wank

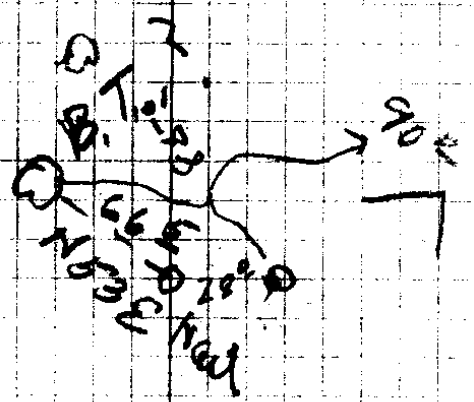

Hub offset 250 ft.
STORE

180 chs

SE EXT "L" COR

45
30

3

16" W Oak

Marked ^{with} CI 38 CS BT

S 13° W
710 ft

SW Cor
1" X 30" I Pipe

20" W Oak Marked CI 38 CS
BT

SE
EXT "1"
or
Most Eastealy
SE Cor

SGI W 84.9 ft
SE Cor CI 38
12" X 12" X 12" above
ground

All
Recorded


Interior W Cor
1" X 30" I Pipe
14" W Oak

S 74° E 158 1/2 ft

Most Southernly
SE EXT "2"
Cor

1" X 24" IP
10" W Oak Marked
CI 38 CS BT

By N 75° 45' W 14 1/2 ft

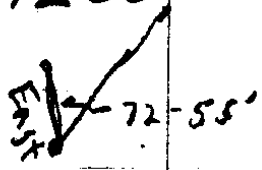① Cor mtn ⁴ " 248-53 15-4			N 89 E
295 ⁺ 5835	218-33		N 20 E N 21-28 E
Δ 1			
5950	72-55		N 19 W N 17-05 W
Cor?			
716			
2 Δ 95 ⁴			
7190			
Δ 3			
9 ⁶ 2363	2324		East
S.W. Cor.			
Hydr temp			
13.45 ¹	112		
200 ²	144.3		
Δ 5			
	916		
Δ 4			
	1112	180 ⁰	
A 3			
	2316	180 ⁰	
Δ 2			
300 ¹	2185		
430 ²	299.1	180 ⁰ RT	West
Δ 1			
SE EXT	40 ⁰		West
L. Cor.			

