


City of Roseburg


Sept 1937

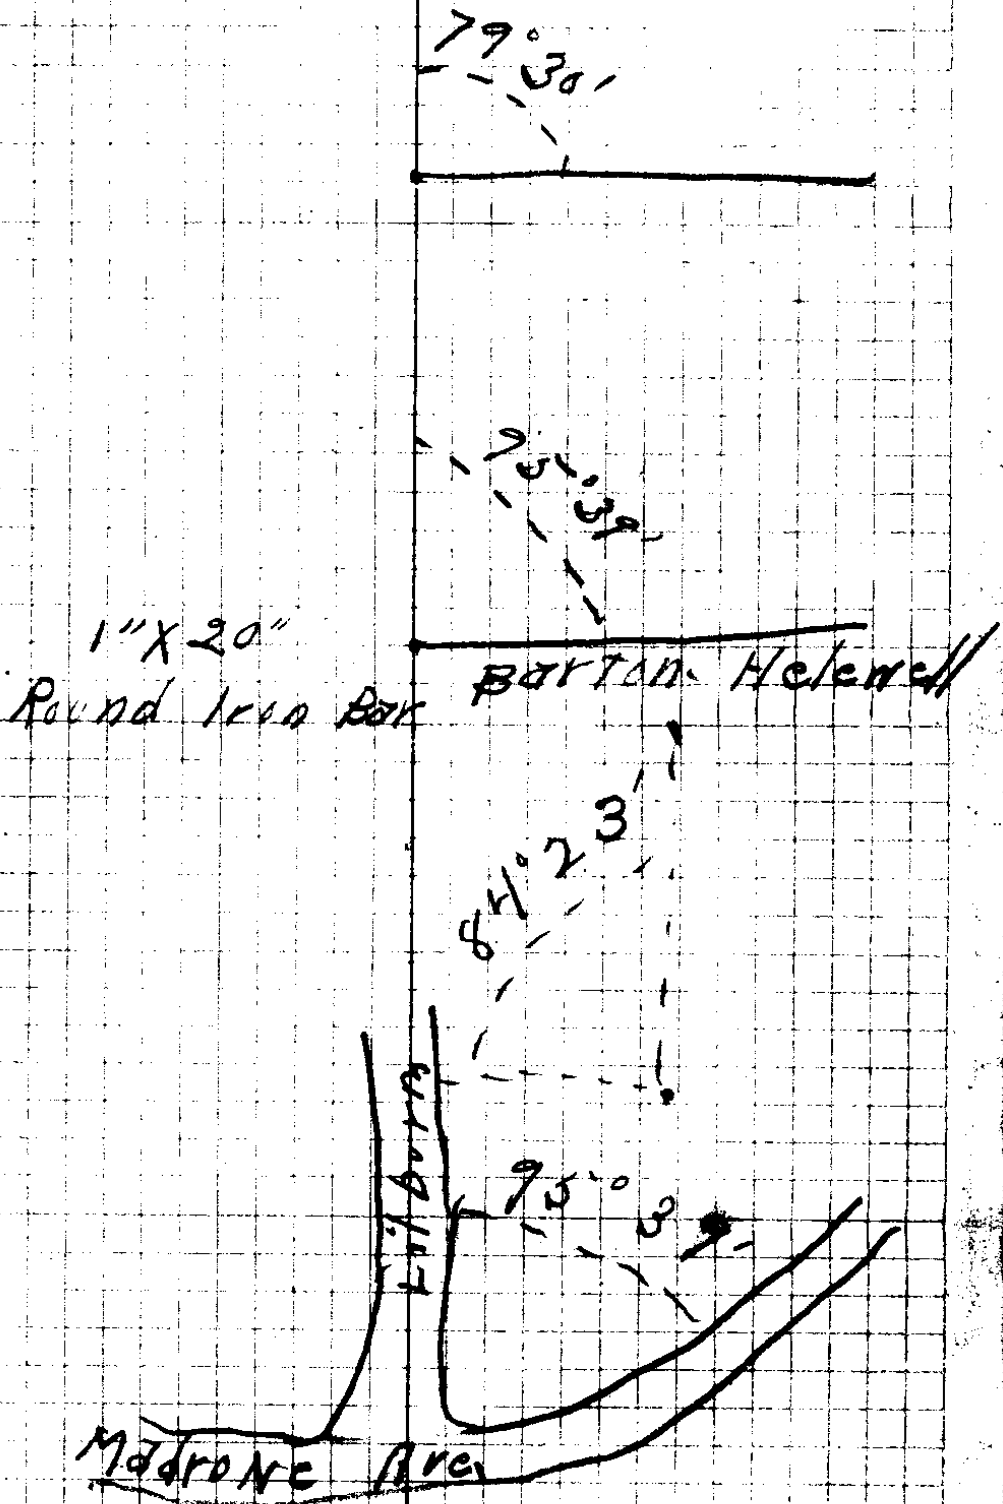

C. S. File No. 15/10

City of Roseburg

Sept 1937

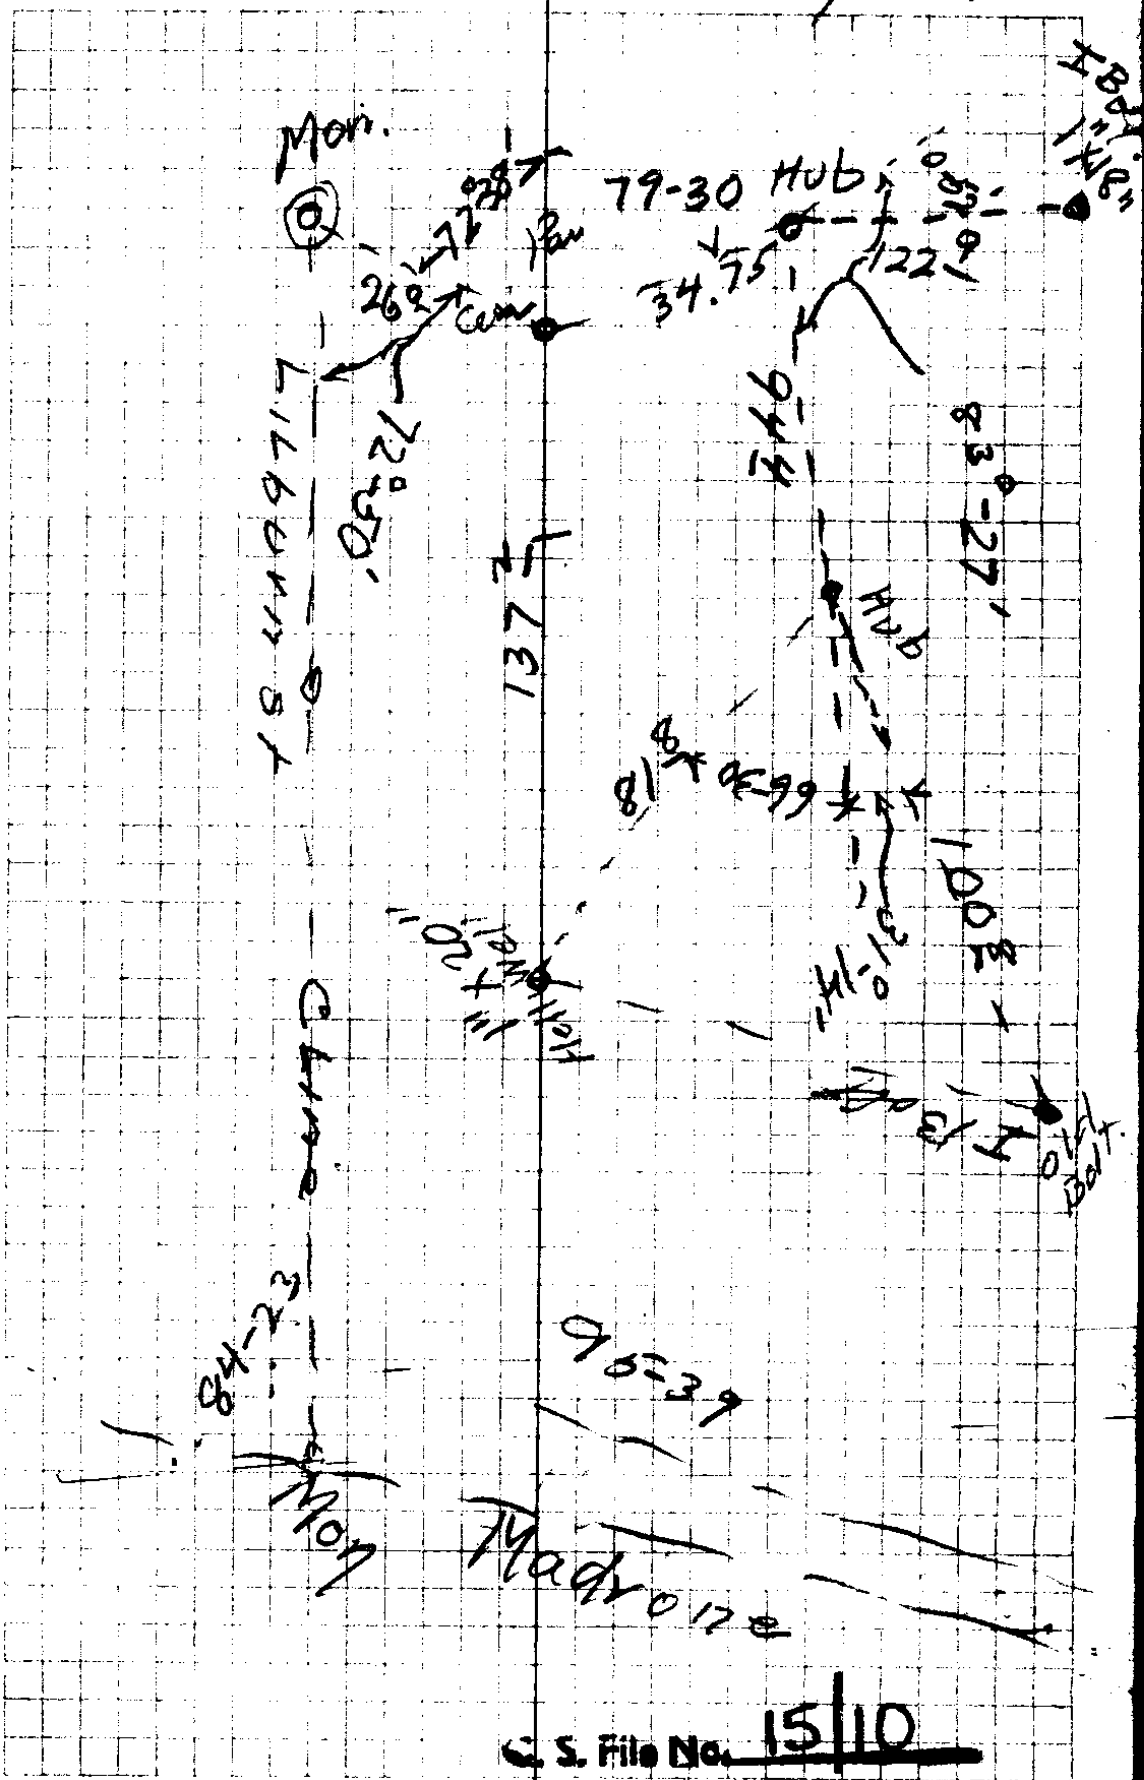

C. S. File No. 15/10

CS FILE FOLDER

CONTAINS

MORE

INFORMATION