


Dec 7, 1936  
 A Boyer  
 Chas Neal

15-17A  
 N  
 ↑

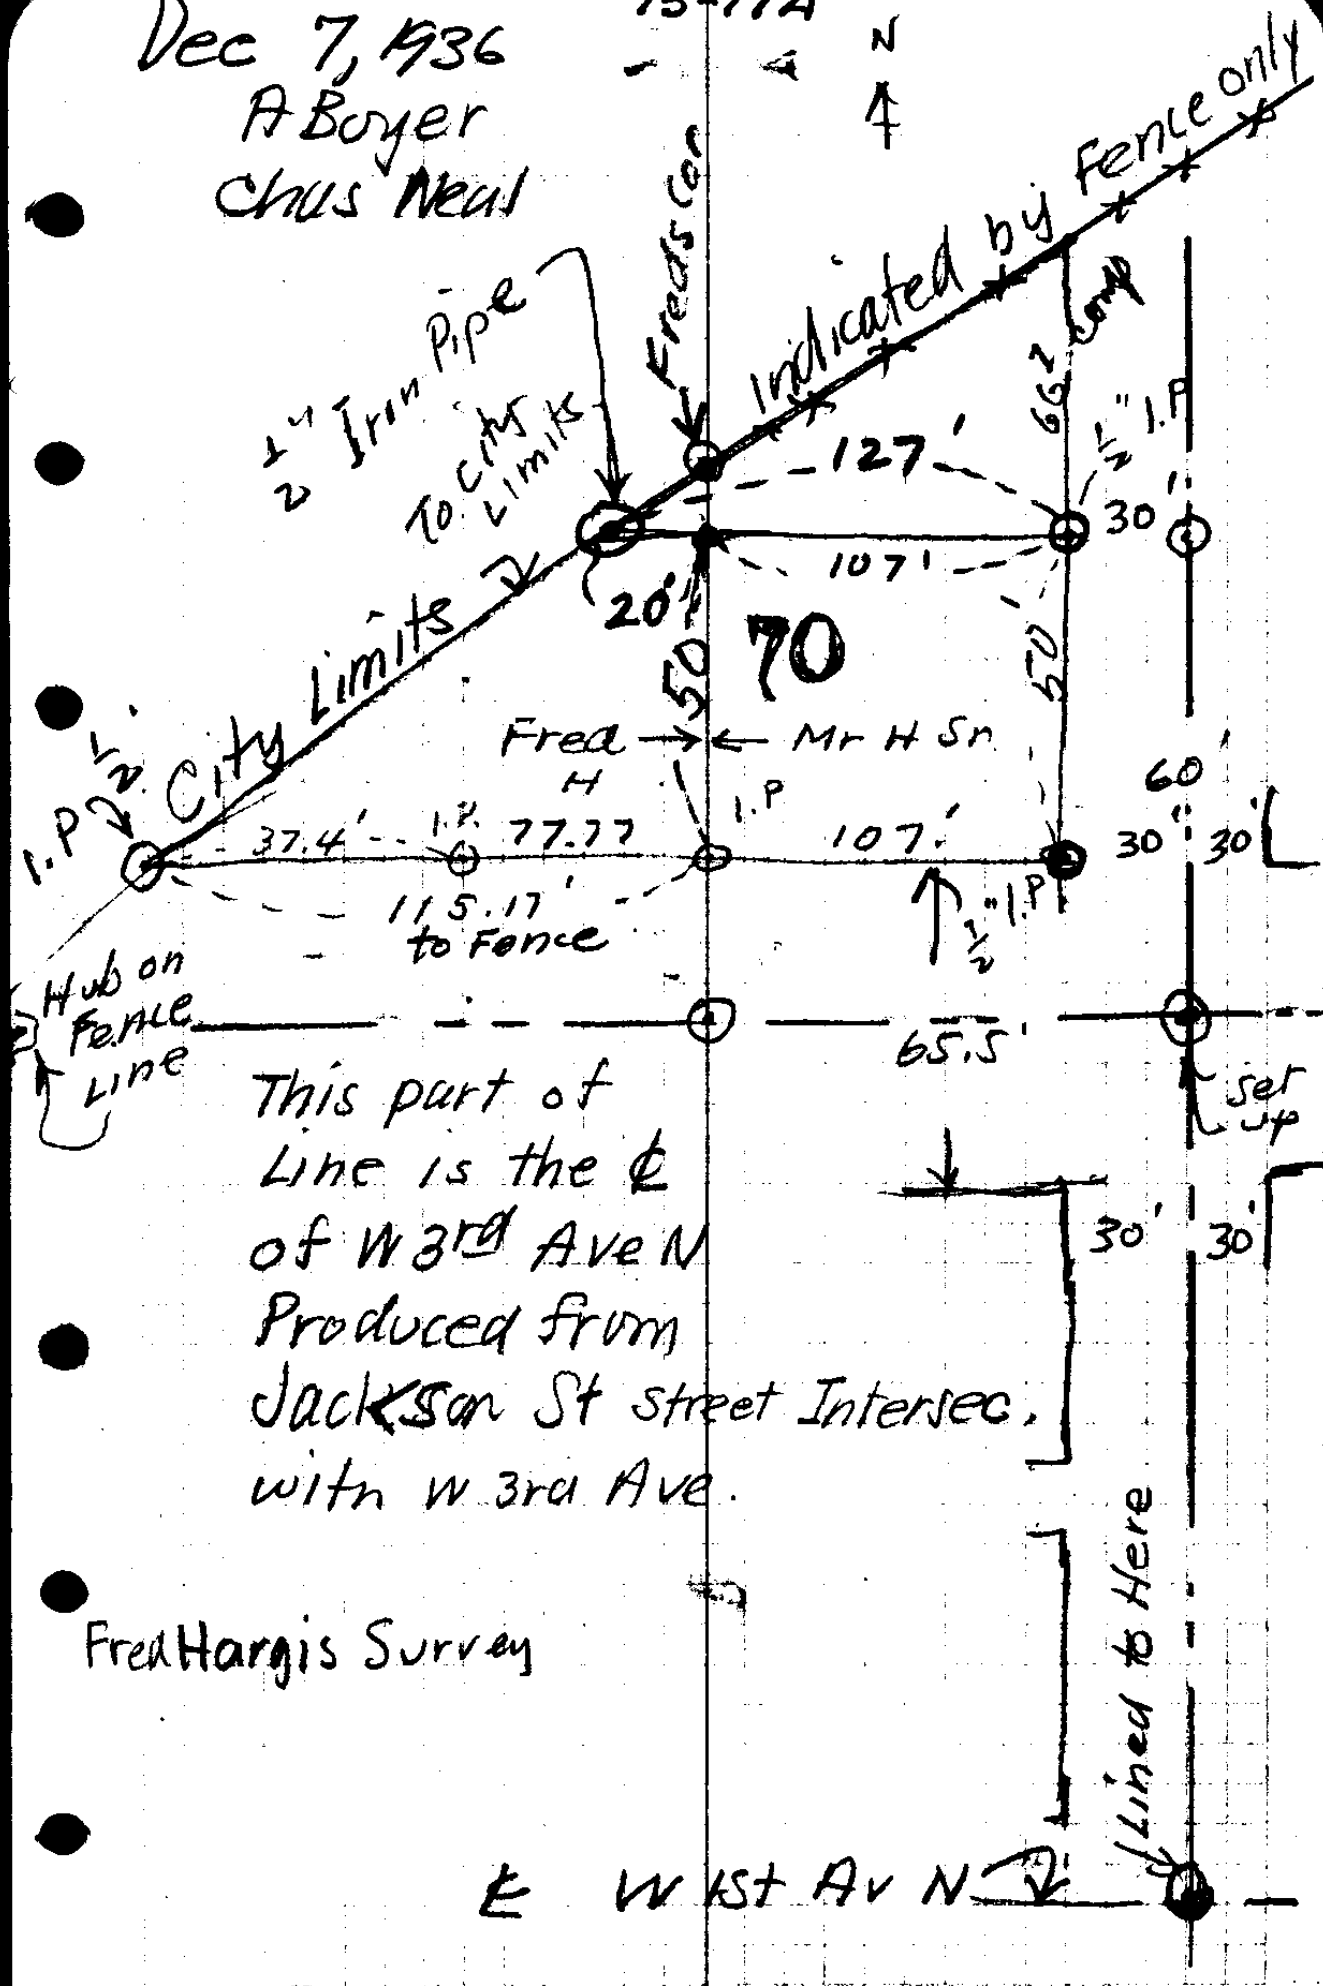

This part of  
 line is the  $\phi$   
 of W 3rd Ave N  
 Produced from  
 Jackson St street Intersec.  
 with W 3rd Ave.

Fred Hargis Survey

E W 1st Av N