


Mar. 3 - 1937

Eppstein

Lane

Richardson


Line Through center of Lot
13 For {Charlie Johns
Billie Vinson

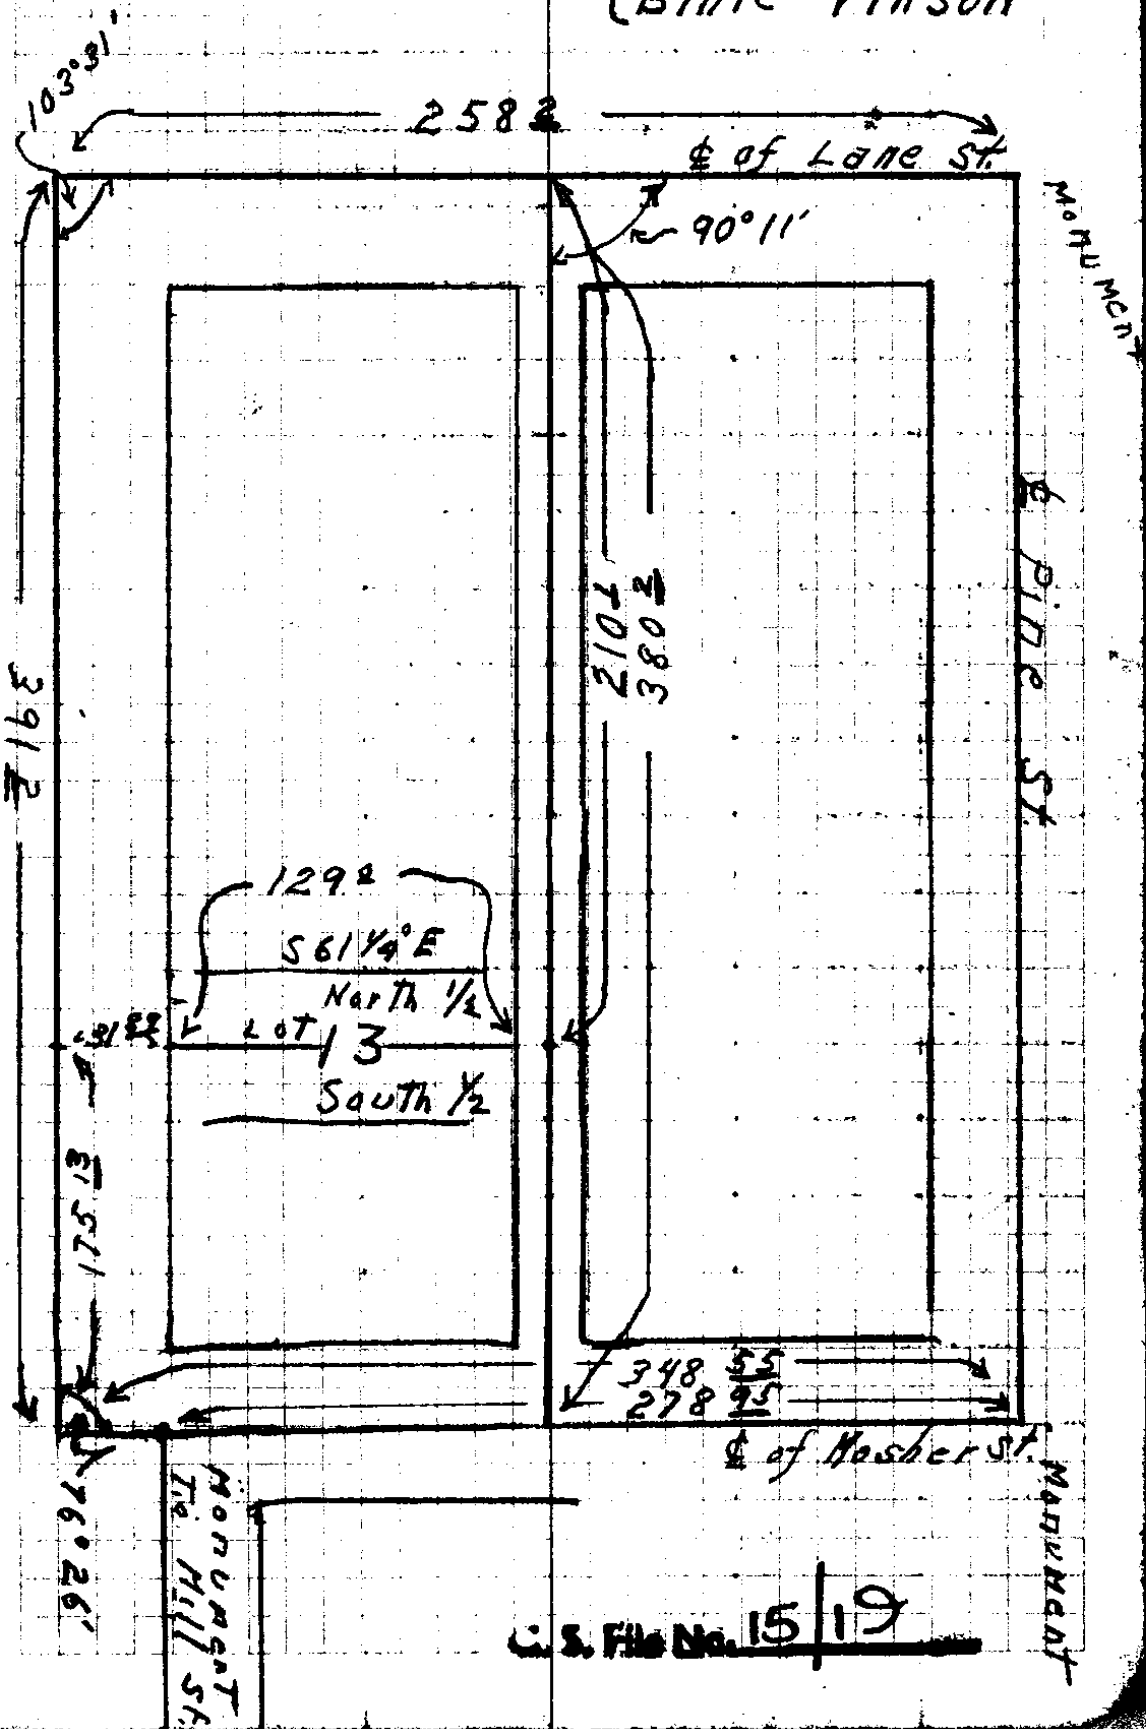

C. S. File No. 15 | 19

Block 55


R.R. Add.

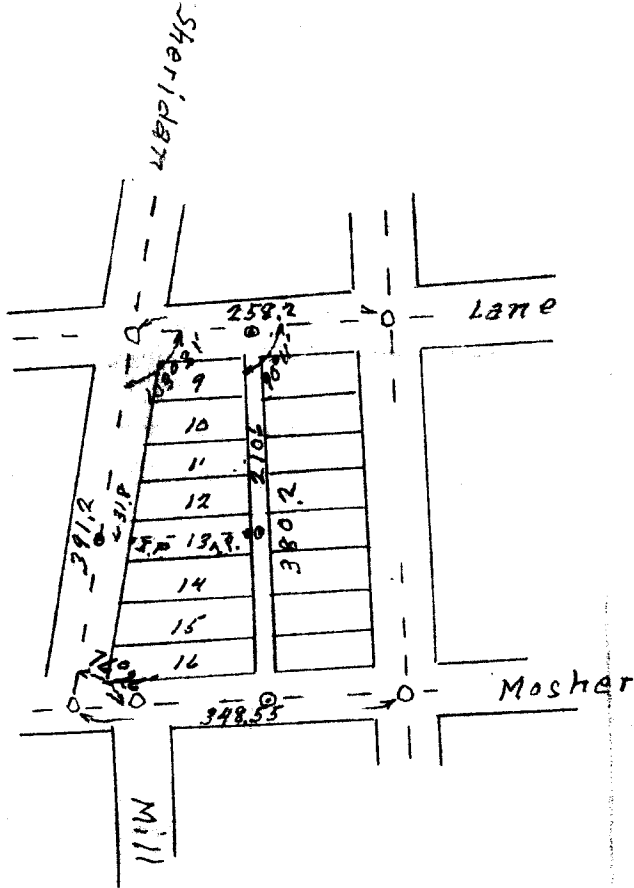

more
of
the
same

21 FEBRUARY 21 1917

Orig Pipes Found.
No Map made.

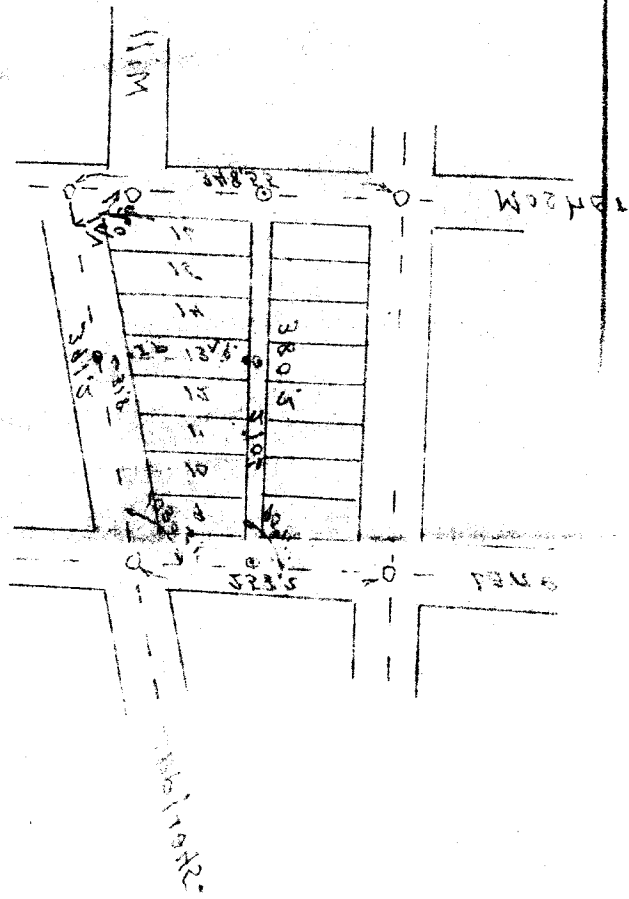

10 ROOM

10 ROOM