

File No. 15/21

U. S. file No. 15/21

15-21

ST + A - R Elev

498.70

TP 7.28 505.98^v
 499.74 499.74 ^{499.13} ^{496.96} 494.42
 6.2 ^{6.2} ^{6.2} ^{6.2} ^{7.0} ^{7.4} ^{7.94} ^{8.12}
 0+00 0+00 +0+12 +25 45 65 85 92
 499.86 500.08 99.8 99.1 98.4 98.5 98.5

0+12 6.1 5.9 6.2 6.6 7.1 7.5 7.5
0+00 +0+12 25 45 65 85 92
 500.08 500.3 500.1 500.3 500.6 499.8 99.2 98.6

0+16 5.9 5.7 5.2 5.7 5.5 6.2 6.5 7.2
0+12 12 25 45 5W 65 85 92
 500.28 500.44 01.2 500.8 500.4 500.7 499.6 498.1

0+20 5.7 5.6 4.8 4.7 5.2 5.4 5.7 6.2 7.9
0+16 SW 12 25 45 5W 65 85 92
 501.54 501.6 501.6 401.7 501.83 501.3 501.3 500.7 500.0

0+40 4.4 4.4 4.2 4.1 4.15 4.7 4.7 5.3 6.0
0+20 SW 12 25 45 SW 65 85 92
 502.68 502.68 504.0 502.8 02.4 01.7 501.2

+60 3.3 3.2 3.0 3.2 3.6 4.3 4.8
0+40 SW 12 25 45 85 92
 503.78 504.0 503.9 03.5 503.4

0+80 2.2 2.0 2.1 2.6 2.6 3.8
0+60 SW 12 25 3.8
 504.98 505.1 504.8 504.4 504.5

1+00 1.0 0.9 1.2 1.6 1.5
0+80 SW 12 25 3.0
 506.22 506.22 06.3 05.9 05.4

TP 5.91 511.52 0.37 505.61
 506.22 06.3 05.9 05.4
 1+20 5.3 5.2 5.6 6.1 6.2 5.053
0+80 SW 12 25 3.0

8.12⁺ 497.86


Case No. 15/21

511.52
 507.32 07.2 07.1 06.6 05.4 = 505.0
 1+40 $\frac{4.2}{0.0}$ $\frac{4.0}{SW}$ $\frac{4.2}{12}$ $\frac{4.9}{25}$ $\frac{5.4}{46}$ $\frac{5.7}{65}$ $\frac{6.5}{85}$
 504.52 508.8 08.6 507.9 507.8 506.8 506.0
 1+60 $\frac{3.0}{0.0}$ $\frac{2.7}{SW}$ $\frac{2.9}{12}$ $\frac{3.6}{25}$ $\frac{3.7}{COV Hous S.W.}$ $\frac{4.7}{62.8}$ $\frac{5.0}{85}$

7.68 505.54 on 92
497.86

503.14
 2.4 $\frac{2.3}{503.24}$

502.04
 3.5

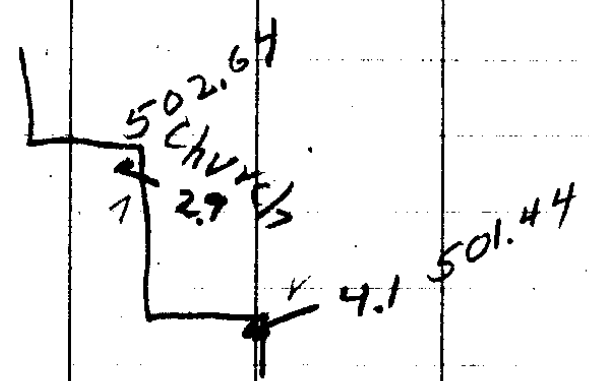

1.70 499.56 on 92
497.86

10.79 488.77 Sewer on Oak St