

22418

22398

44818

22398

17.67

1206.39

122195.18

22418

22398

44818

22398

17.67

1206.39

122195.18

22418

22398

44818

22398

17.67

1206.39

122195.18

38
31
30
32
34
33
35
31
50
18
12
11
13
14
10

381.75
60

321.750
40.219

2 | 17.67
8.88

2 | 283.95
60

141.975

C. S. File No. 161

40.219
3

120.657 + 30 = 150.66

325' 4" on Rose St

STEPHENS

380.92
60

320.920
40.115
3

120.345
30


150.34

284.18
26

224.18
2284.18
142.09

40.115
5

200.575

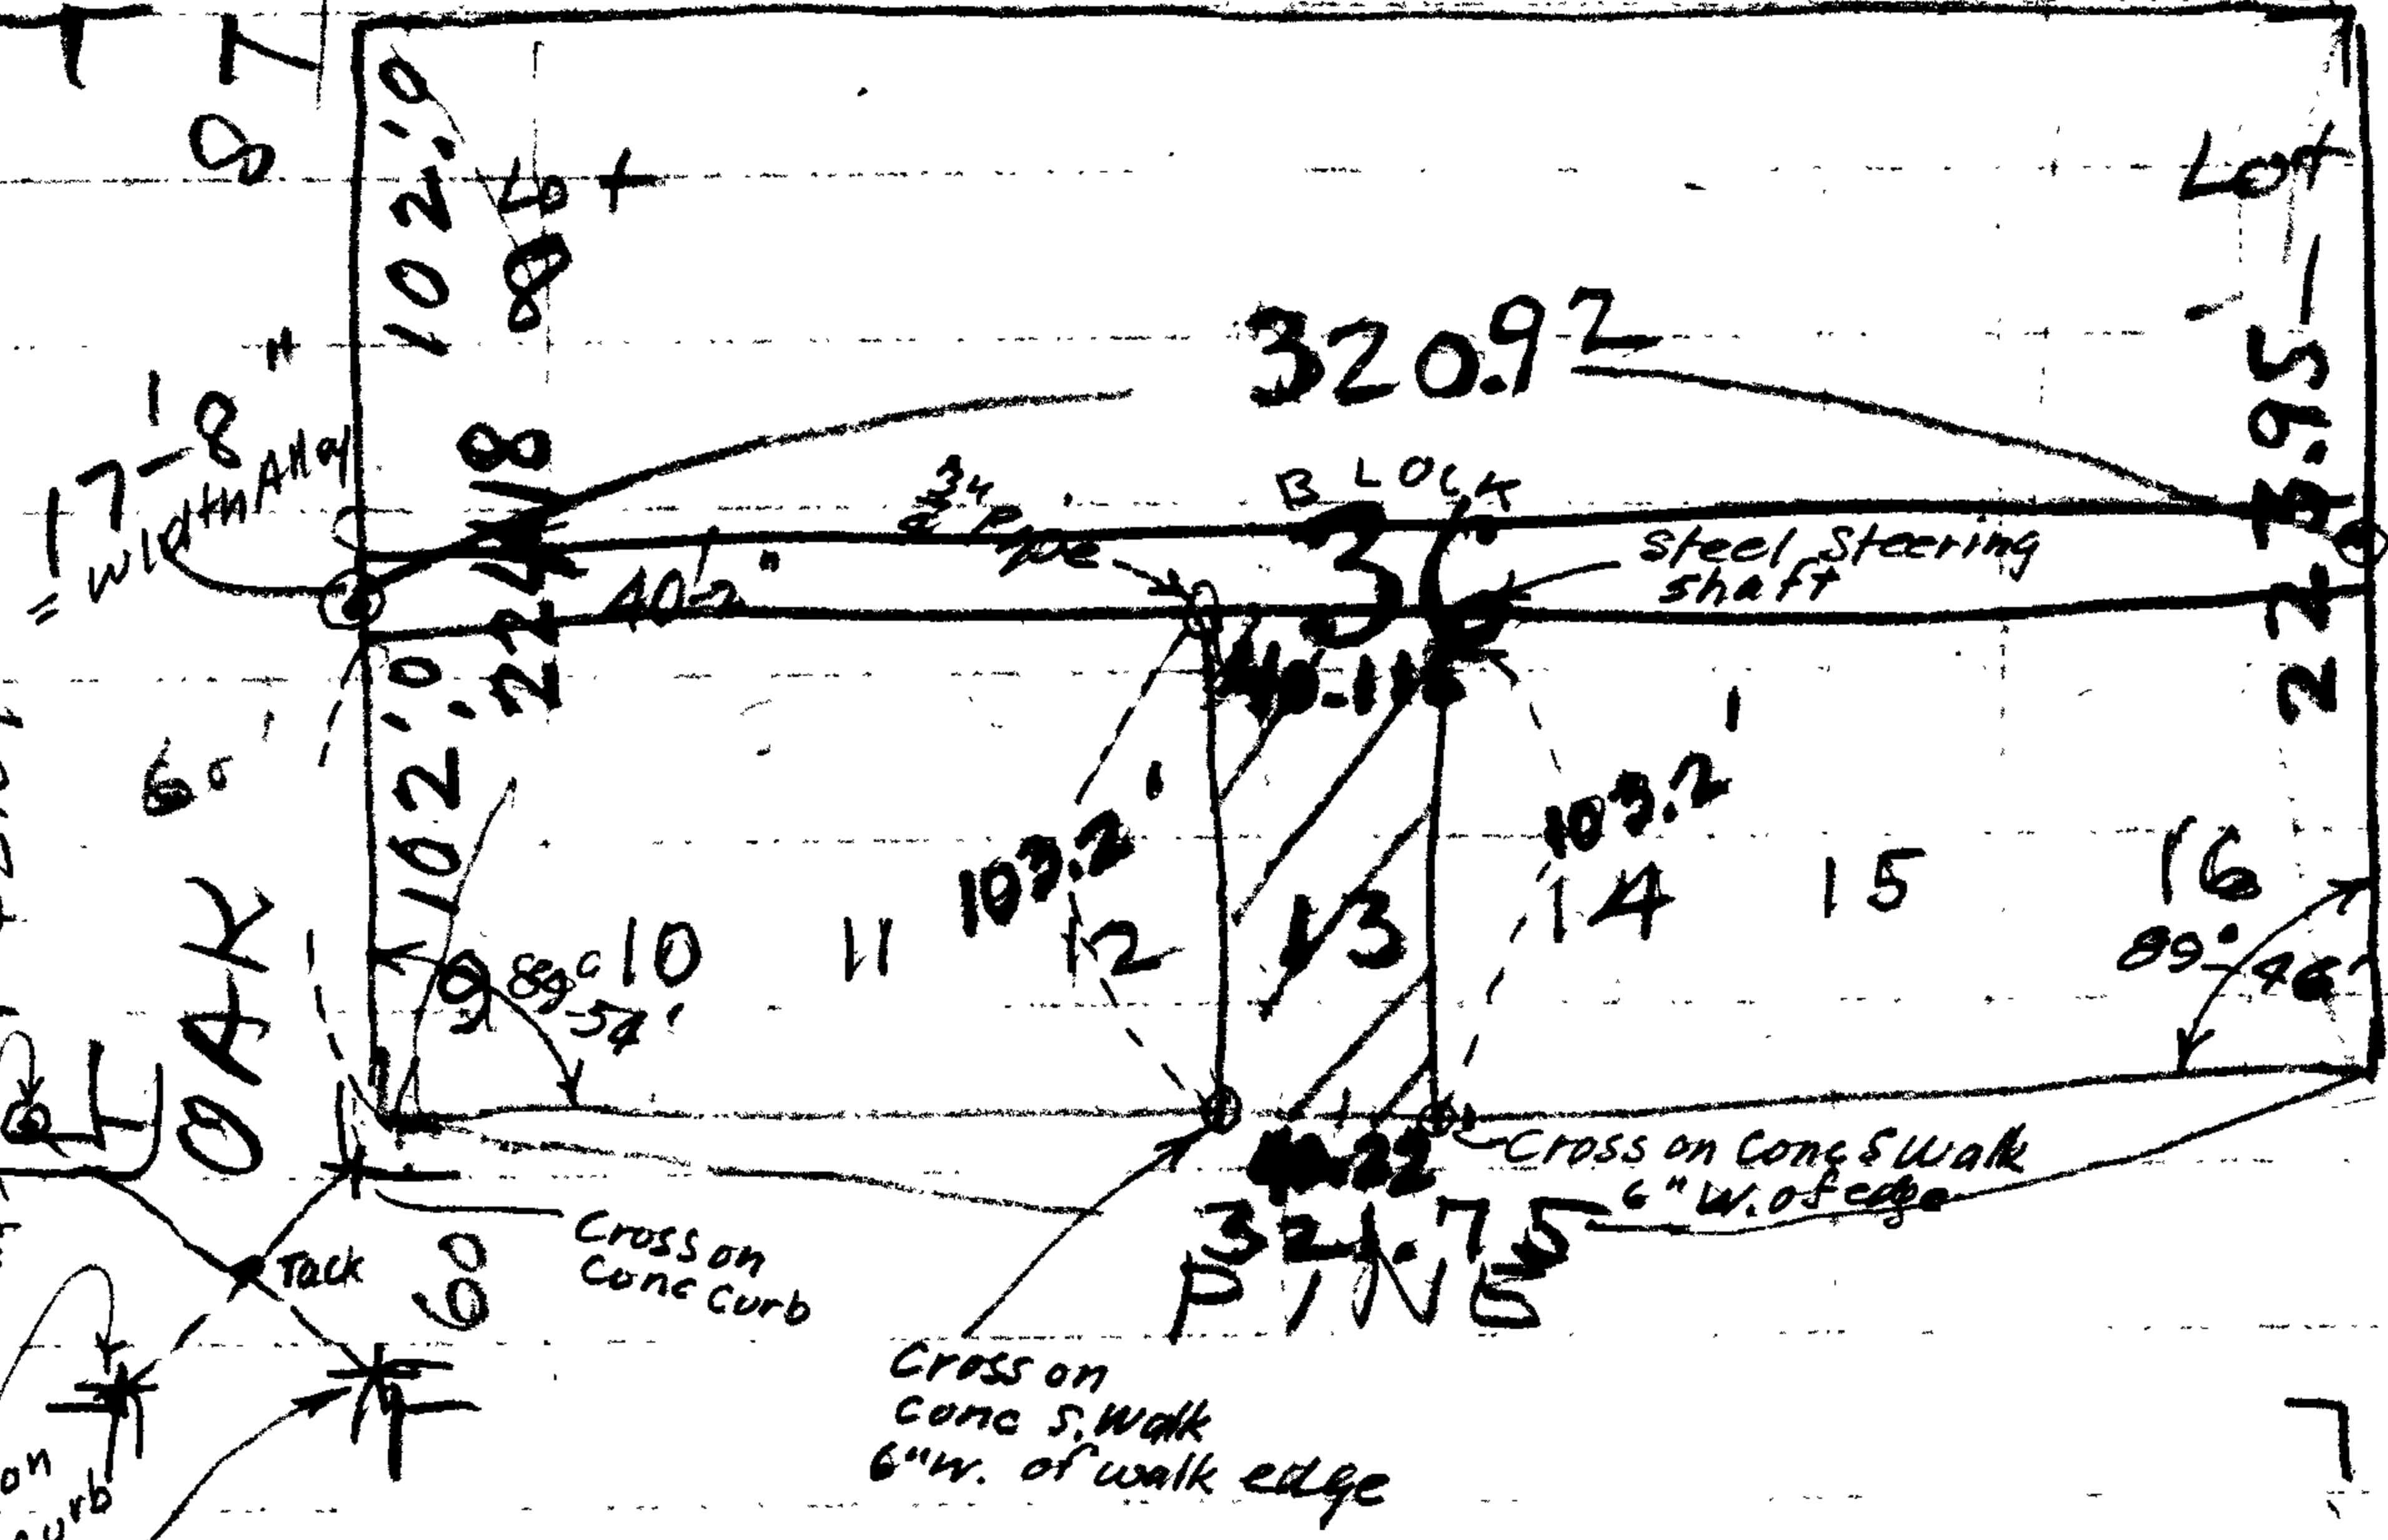

CASS ST

60'

98/627
Ohman to
Hansen
Lot 13 B136

Block 36 - Lot 13
R. R. Add.
Roseburg Ore
Survey for
Hans Hansen
Oct 25-'38
HL
AL