


A Boyer
Harvey
Eppstein Jr

240
346 16-17 93.61 to
279.6
120
159.6

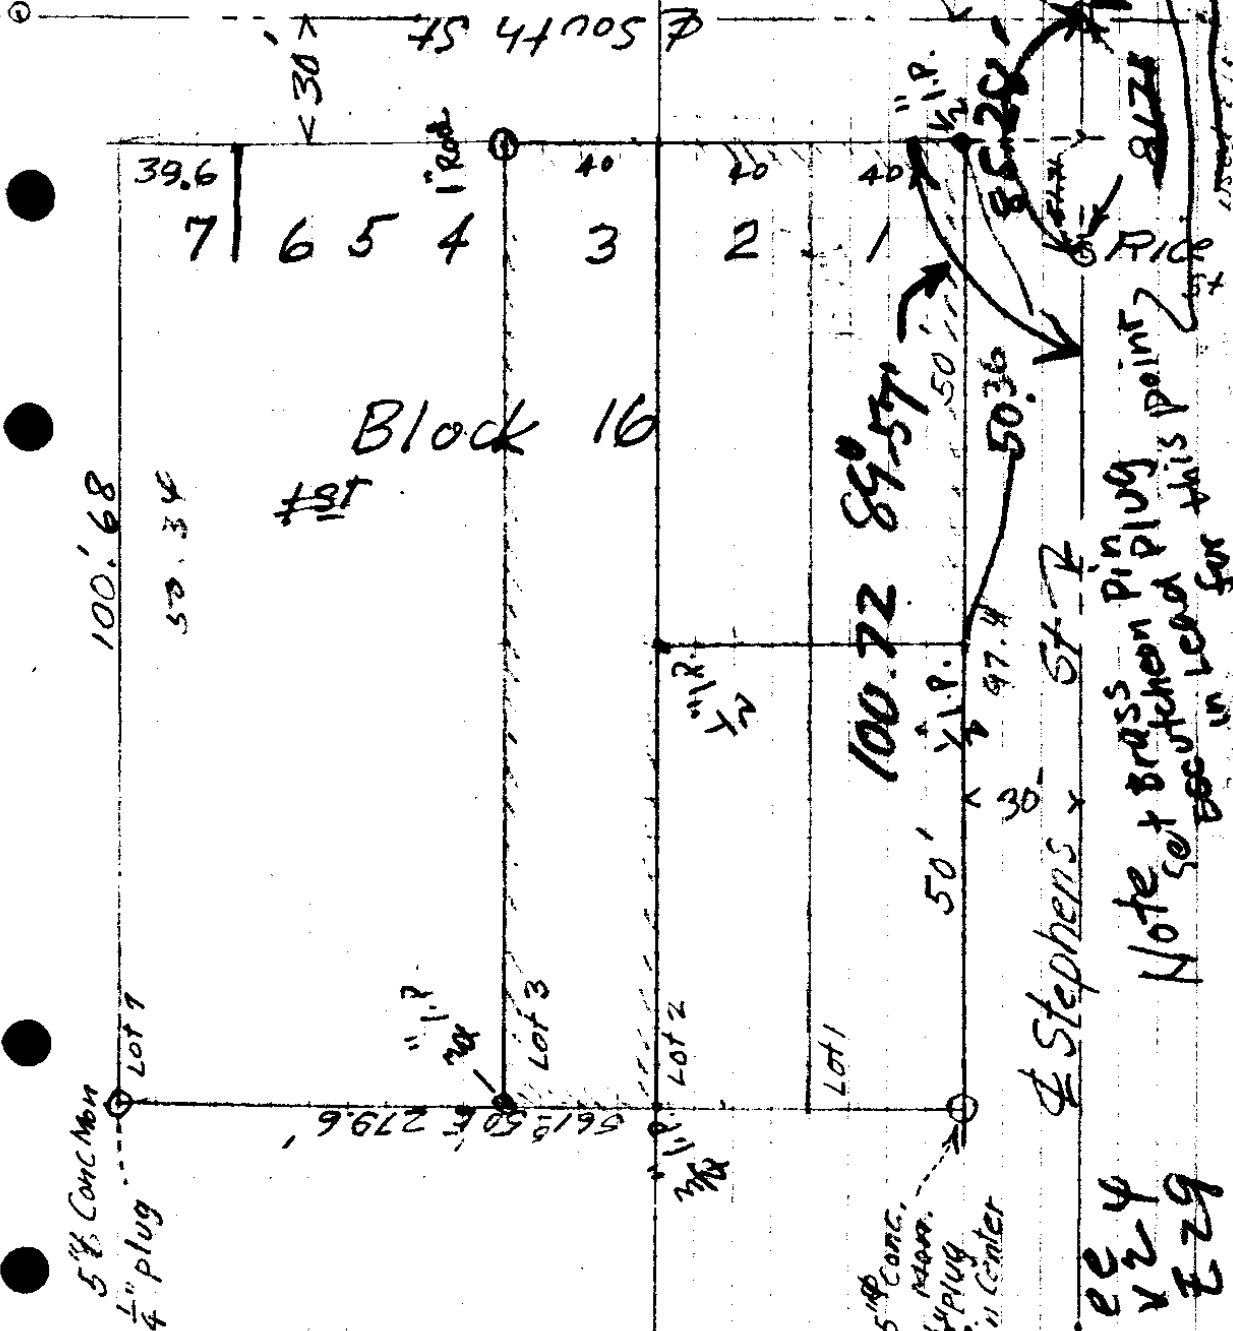

100.68

39.6

7 | 6 5 4 3 2 1

Block 16

100.72 89.57

Stephens St

Note set brass pin plug
at this point
see in lead for

5" Conc Mon
1" plug

5" Conc.
Mon.
1" plug
" center

First Add to Waites Add

81.71
30
51.71

2 | 100.72
50.36

W.J.
Mr Mess
Feb 28-39

See
V 24
E 29
38.72 to
Burk
South