


Main from  
set up  
to here

Sewer  
Manhole  
Caret

set up  
tack

1967

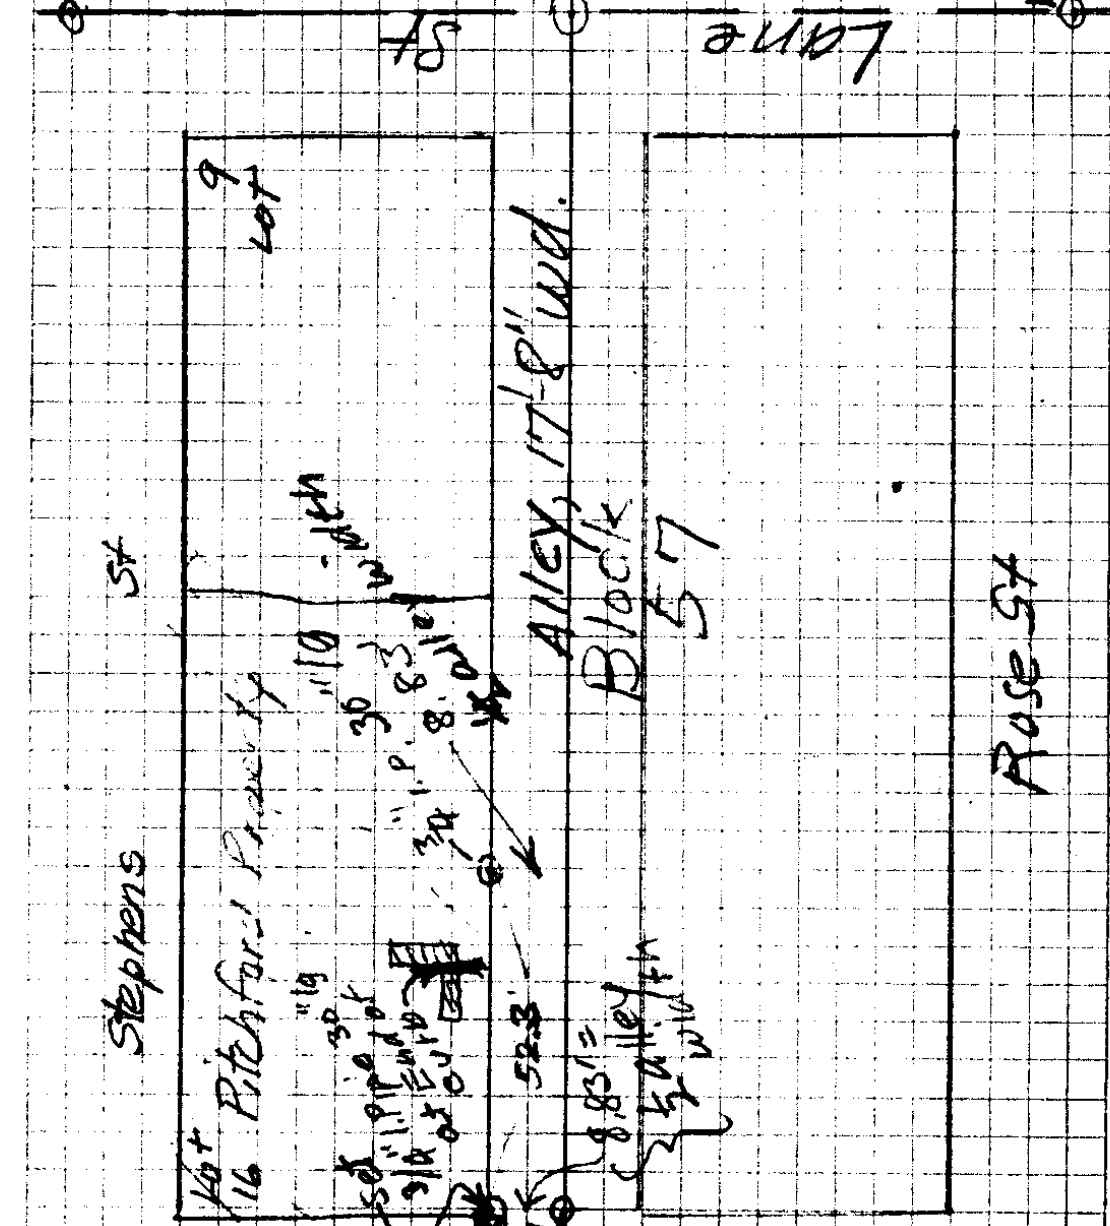

Masher St

curb  
Gutter

old tack

Agnes Pitchford  
Survey

Bl. 57. 0T  
Roseburg


6/3/39 Boyer

P N.E. Richardson

S. File No. 16/28

Stephens  
380.05

16/27

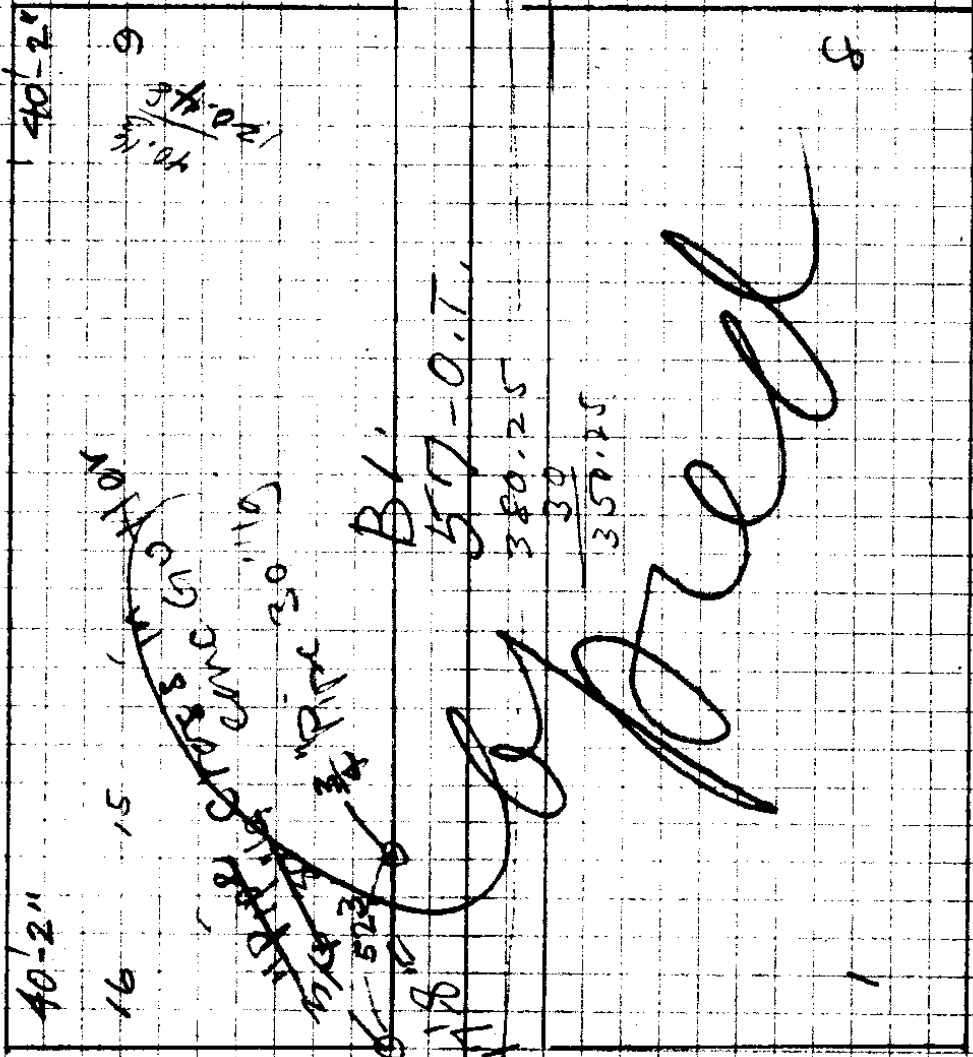

281.62  
140.86 = 2

40.16  
32.12 = 8

B.I.  
517-0.7  
380.25  
30  
350.25

*Handwritten signature*

171.8  
117.8  
51.0  
68  
112.3  
380.25  
68

8320.25  
40.03 ea lot

Mackler

