

N.E. Corner Jno. Yocum
 Donation Land Claim #43
 T.30S; R.5W; W.M.

W 1/2 Cor Sec. 20

CANYONVILLE

PACIFIC
 N. Line of Property & of Irrigable

#99
 Area
 HOUSE
 Yard (No Irrigation)

Umpqua River

Orchard

N.W. 1/4 S.W. 1/4 Sec. 20
 15.6 Ac.

N.E. 1/4 S.W. 1/4 Sec. 20
 16.5 Ac.

Diversion (Pump Site)
 2351' S. & 1292' W. of
 (N.E. Cor. Jno. Yocum D.L.C. 43)

1800'-3" Surface Pipe, Movable
 25 Sprinkler Heads.

N76°30'W 450'

FIELD

Main Pipe Line
 N71°43'W, 900'

FIELD 600' 4" Pipe

PARDEE
 PARKER

South

RIVER BAR
 Irrigable Area Line
 Orchard

700'-6" Pipe

1/16th Corner

S.W. 1/4 SW 1/4 Sec. 20
 7.6 Ac.

S.E. 1/4 S.W. 1/4 Sec. 20
 10.3 Ac.

Riddle

Orchard

Irrigable Area

Total, 50 Ac. to be irrigated.




COUNTY SURVEYOR'S OFFICE ROSEBURG, ORE
 PLAN FOR IRRIGATION OF LAND IN SEC. 20,
 T. 30S; R. 5W. W.M. DOUGLAS COUNTY, ORE.
 To Accompany Application of Mr. Joe Gasati, agent
 for Mr. T. T. Sullivan, of Chicago, Ill; owner,
 For Permit to appropriate water out of S. Umpqua River
 Scale, 1" = 200. Ft. - June, 1939 - A. Boyer, Reg. Engr. Ore Lic. 1581.

4 cor
19-20 = 1-148

16-34 } Stewart 1921-
J J Yocum
Vern Weaver
Set iron pin
36" B.O. - S 13° E 72'
20" B.O. N 60° E 465
Vol 3 pg 105

T30
5

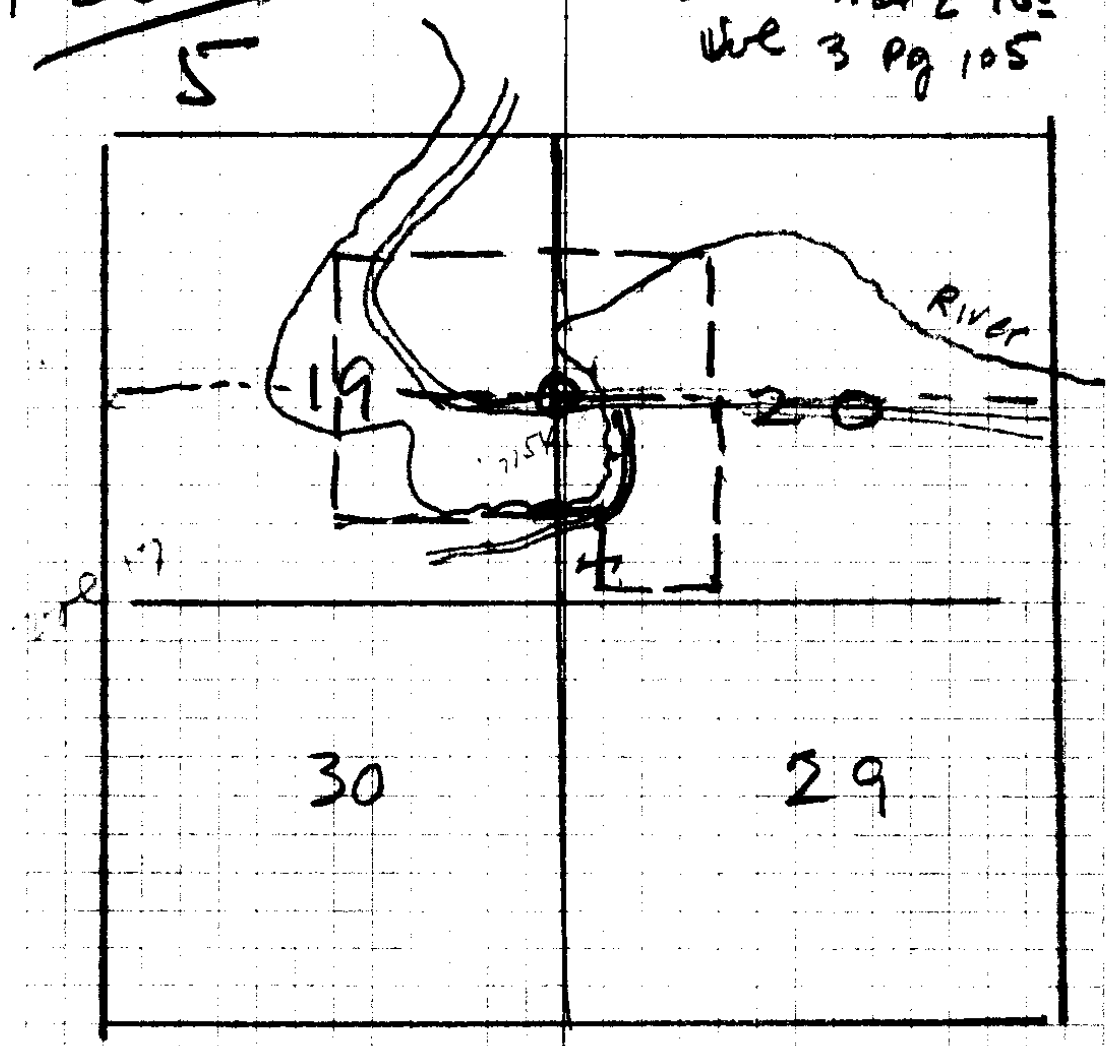

SW corner 47 . 1-145

N bet 19 + 20

- 22 = R bank River
- 44 = 4 cor
- 43 = Road myrt ch to Canyon
- 45 = Rt bank River

CS FILE FOLDER

CONTAINS

MORE

INFORMATION