


Profile Scale, Horiz: 1" = 20'  
 Vert: 1" = 10'

LOT 2, BLOCK C, LAURELWOOD ADD  
 ROSEBURG, ORE.  
 DATA FOR PRIVATE SEWER EASEMENT,  
 FROM ORE. WORLD WAR VETS. STATE AID COMSN.  
 H. L. EPPSTEIN, CITY ENGR  
 JULY 1939  
 SCALE, 1" = 20 ft.  
 Boyer

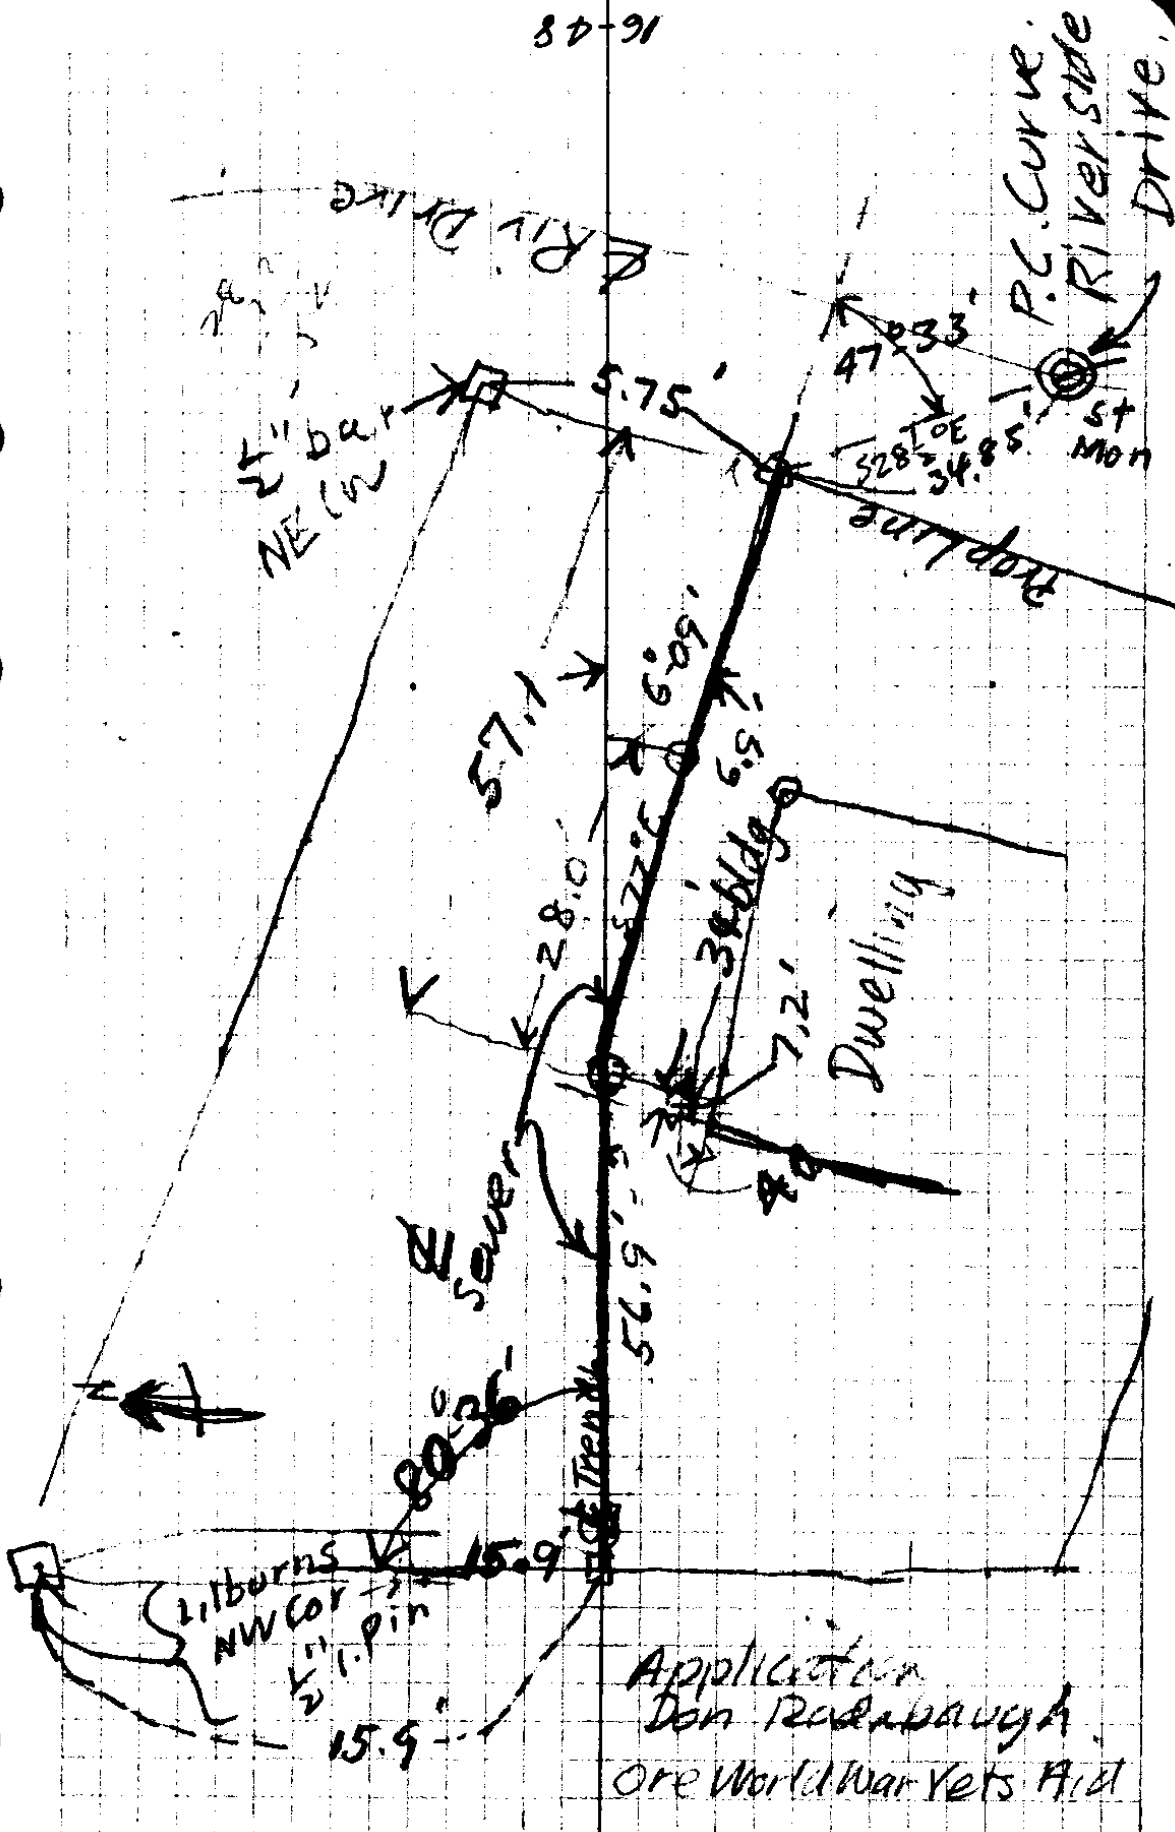

Application  
 Don Radabaugh  
 Ore World War Vets Aid

July 21-1939  
 H. L. Eppstein - NE Richardson - A Boyer.