

Lester Wimberly

Lots 1 to 4 and 10 to 13  
incl.

Block C, Flints Add.

Jan 17, 1940

Jan. 17, 1940.


Boyer, Richardson.

For Lester Wimberly

Found 1" Pipe OK.


Found Orig Hub set 3/4" 1. Pipe

Found Orig Hub set 3/4" 1. P.

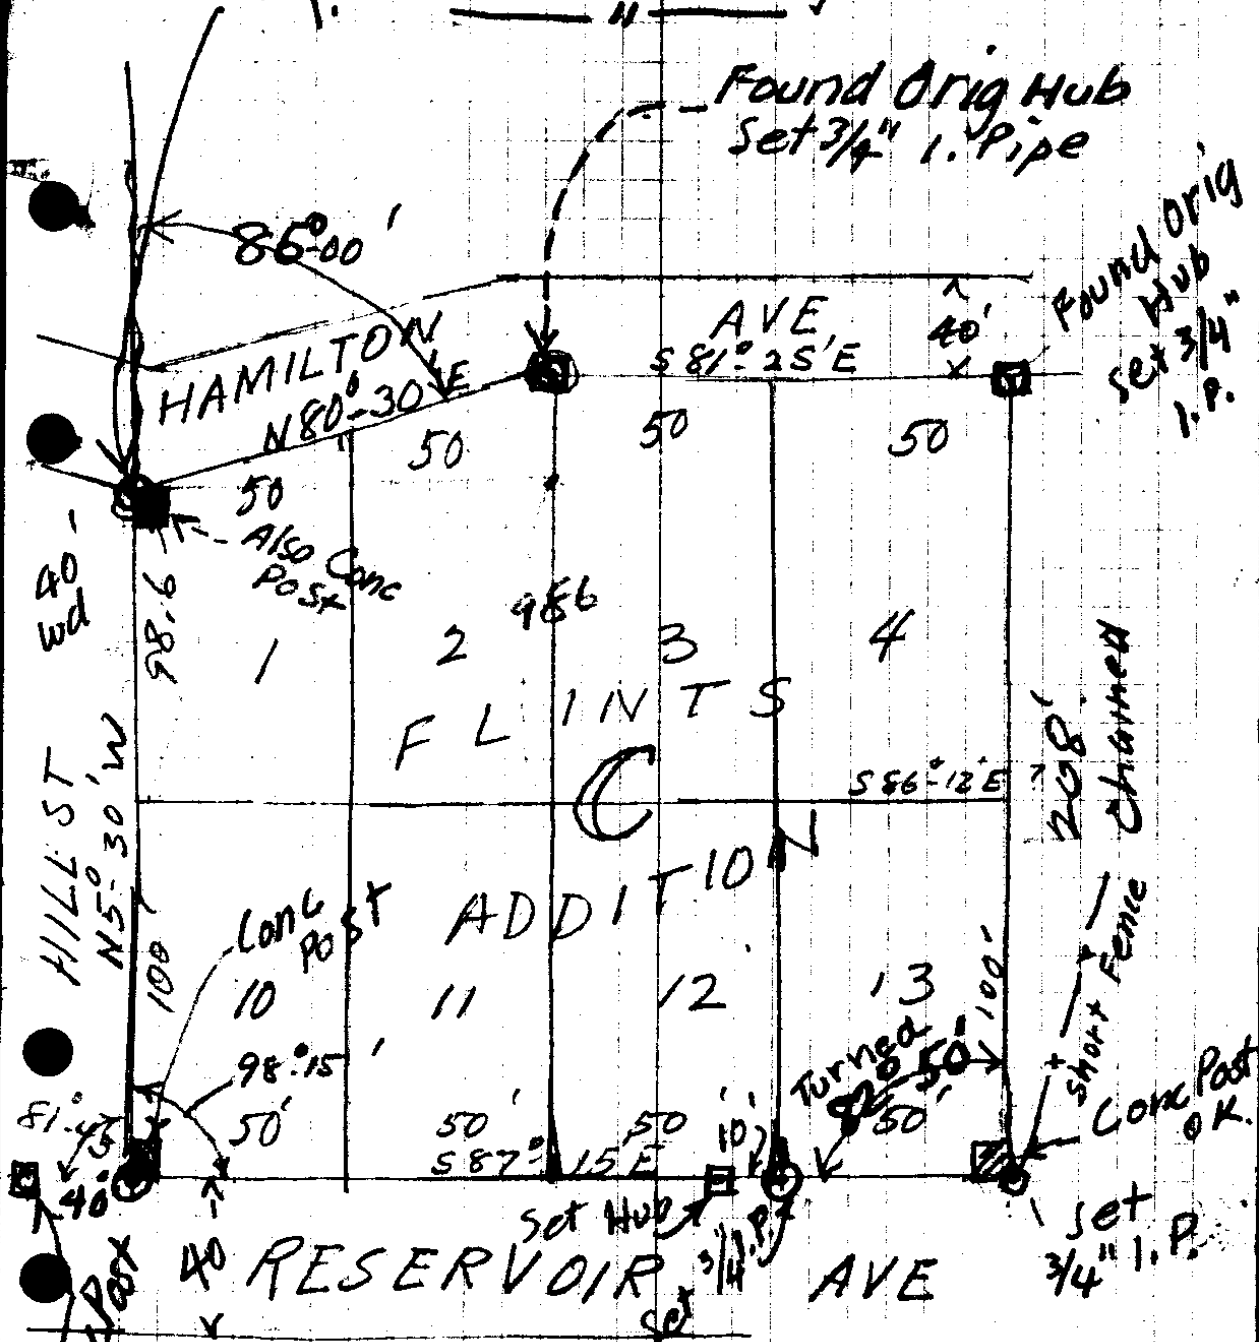

Found 1" Pipe set by HLE for Banister in 1933 (it is just 40' across Hill St to Conc Post at cor Lot 10)

16-54

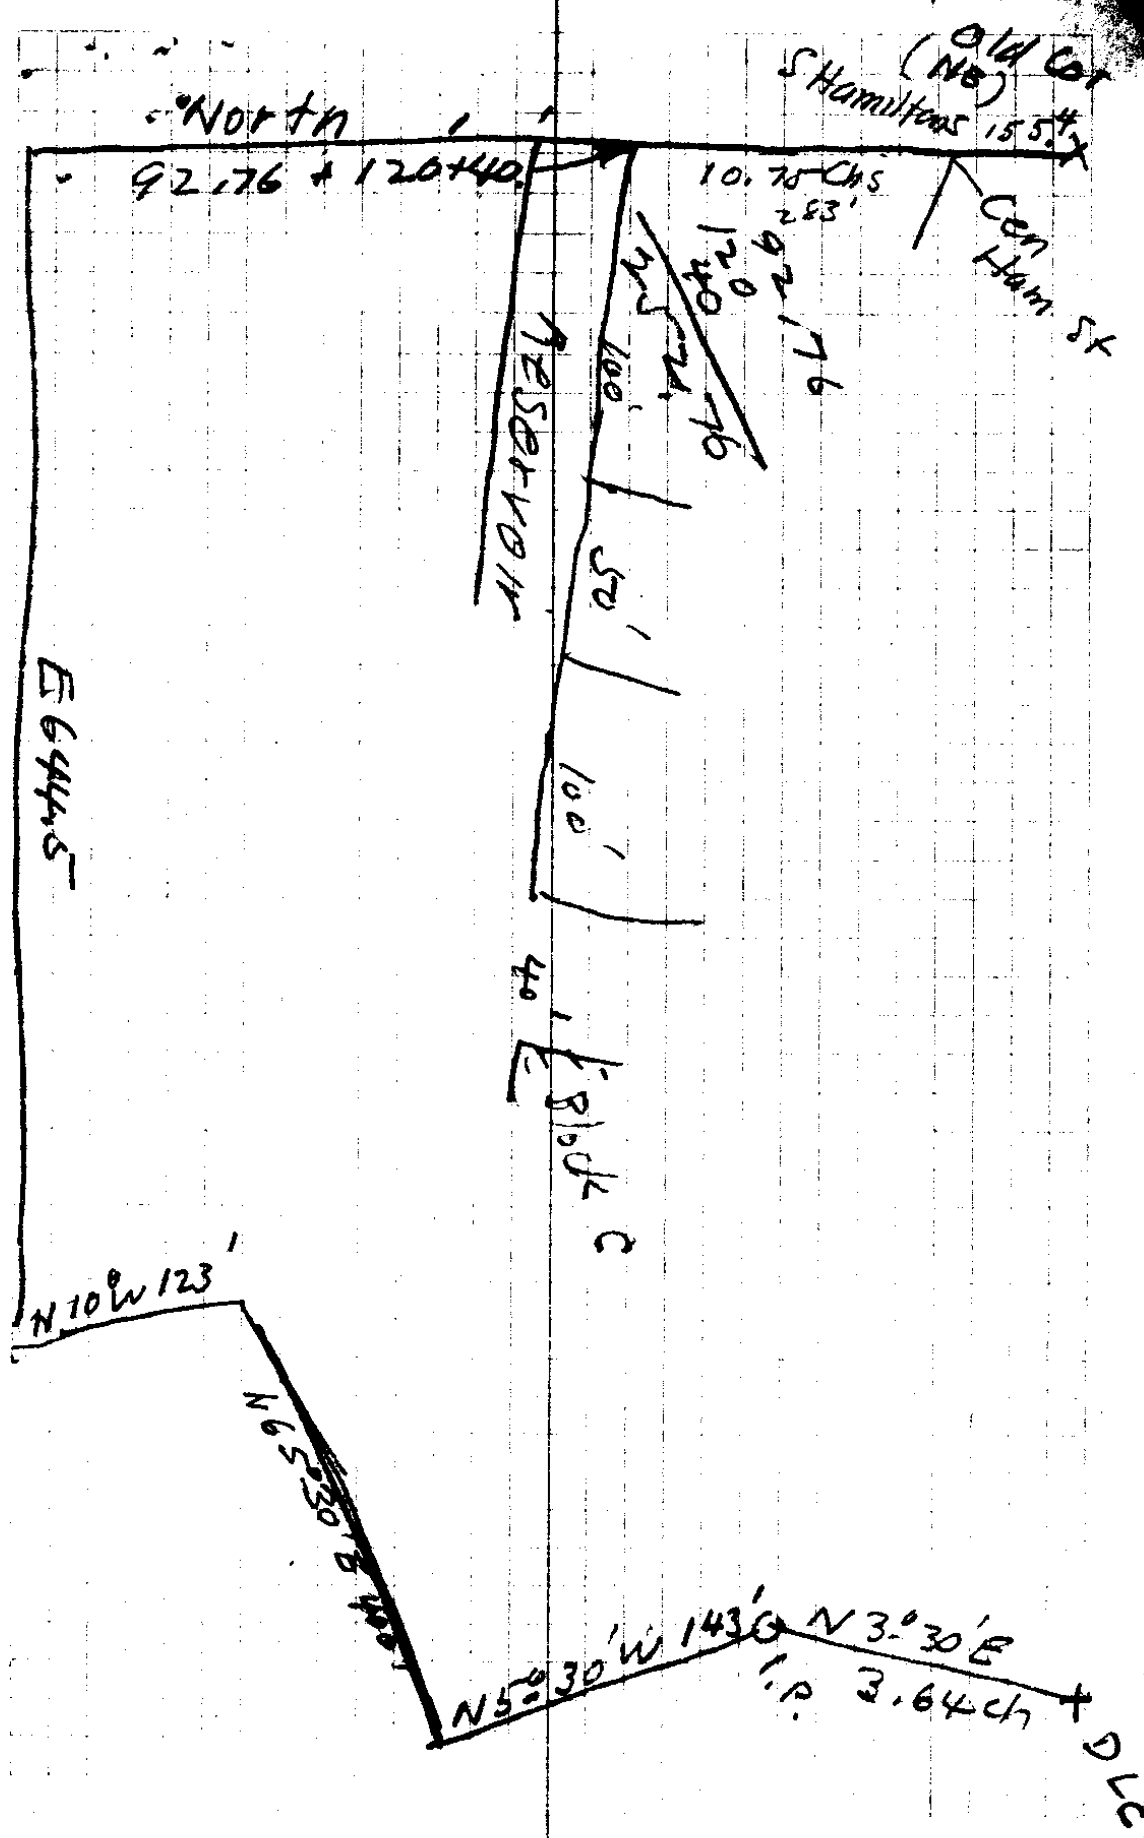

16/54