


N 1/4
E 1/4

St man Found
Cahpooya St

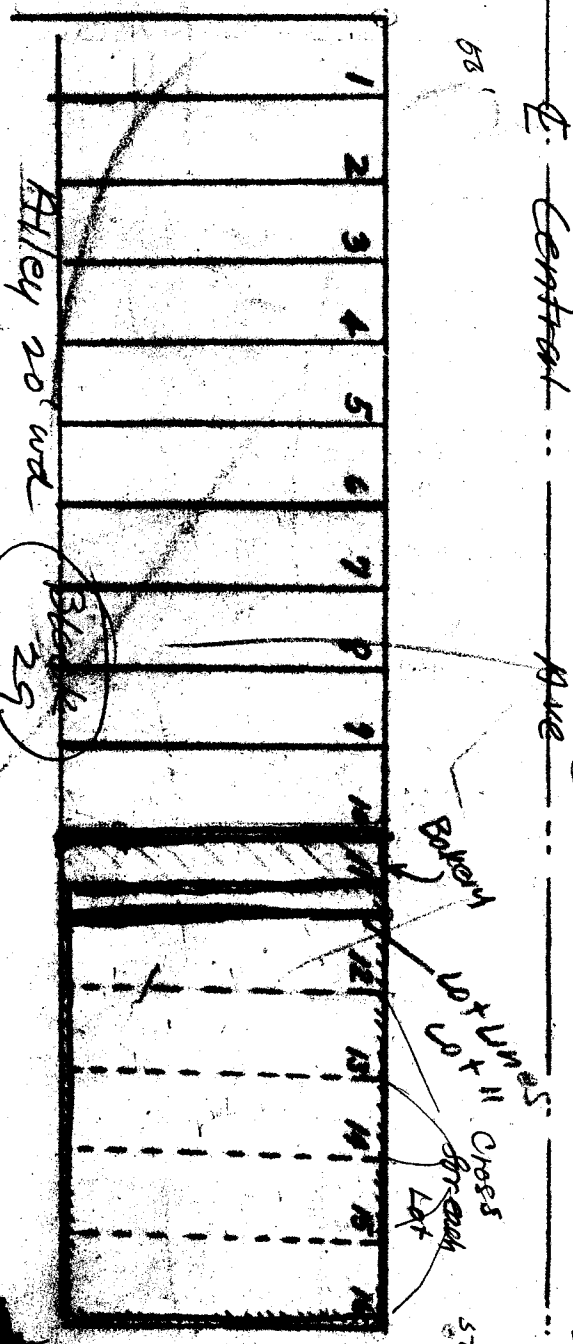


161.75 (Supposed to be 261.55)

Center Ave

CROSS on
concrete wall

State St
St man. Found

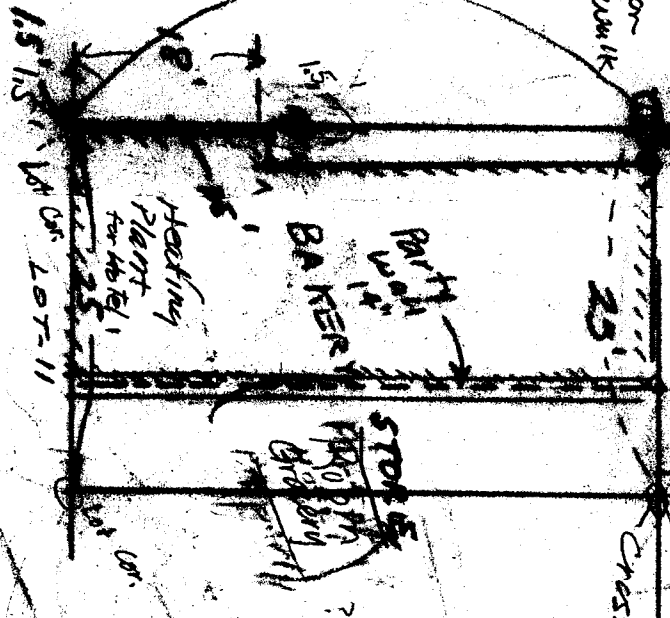

Copy furnished to
Judge Bowke
Dec 15

