


UOL 16/62

MAY 29-1940

Boyer  
Shellabarger

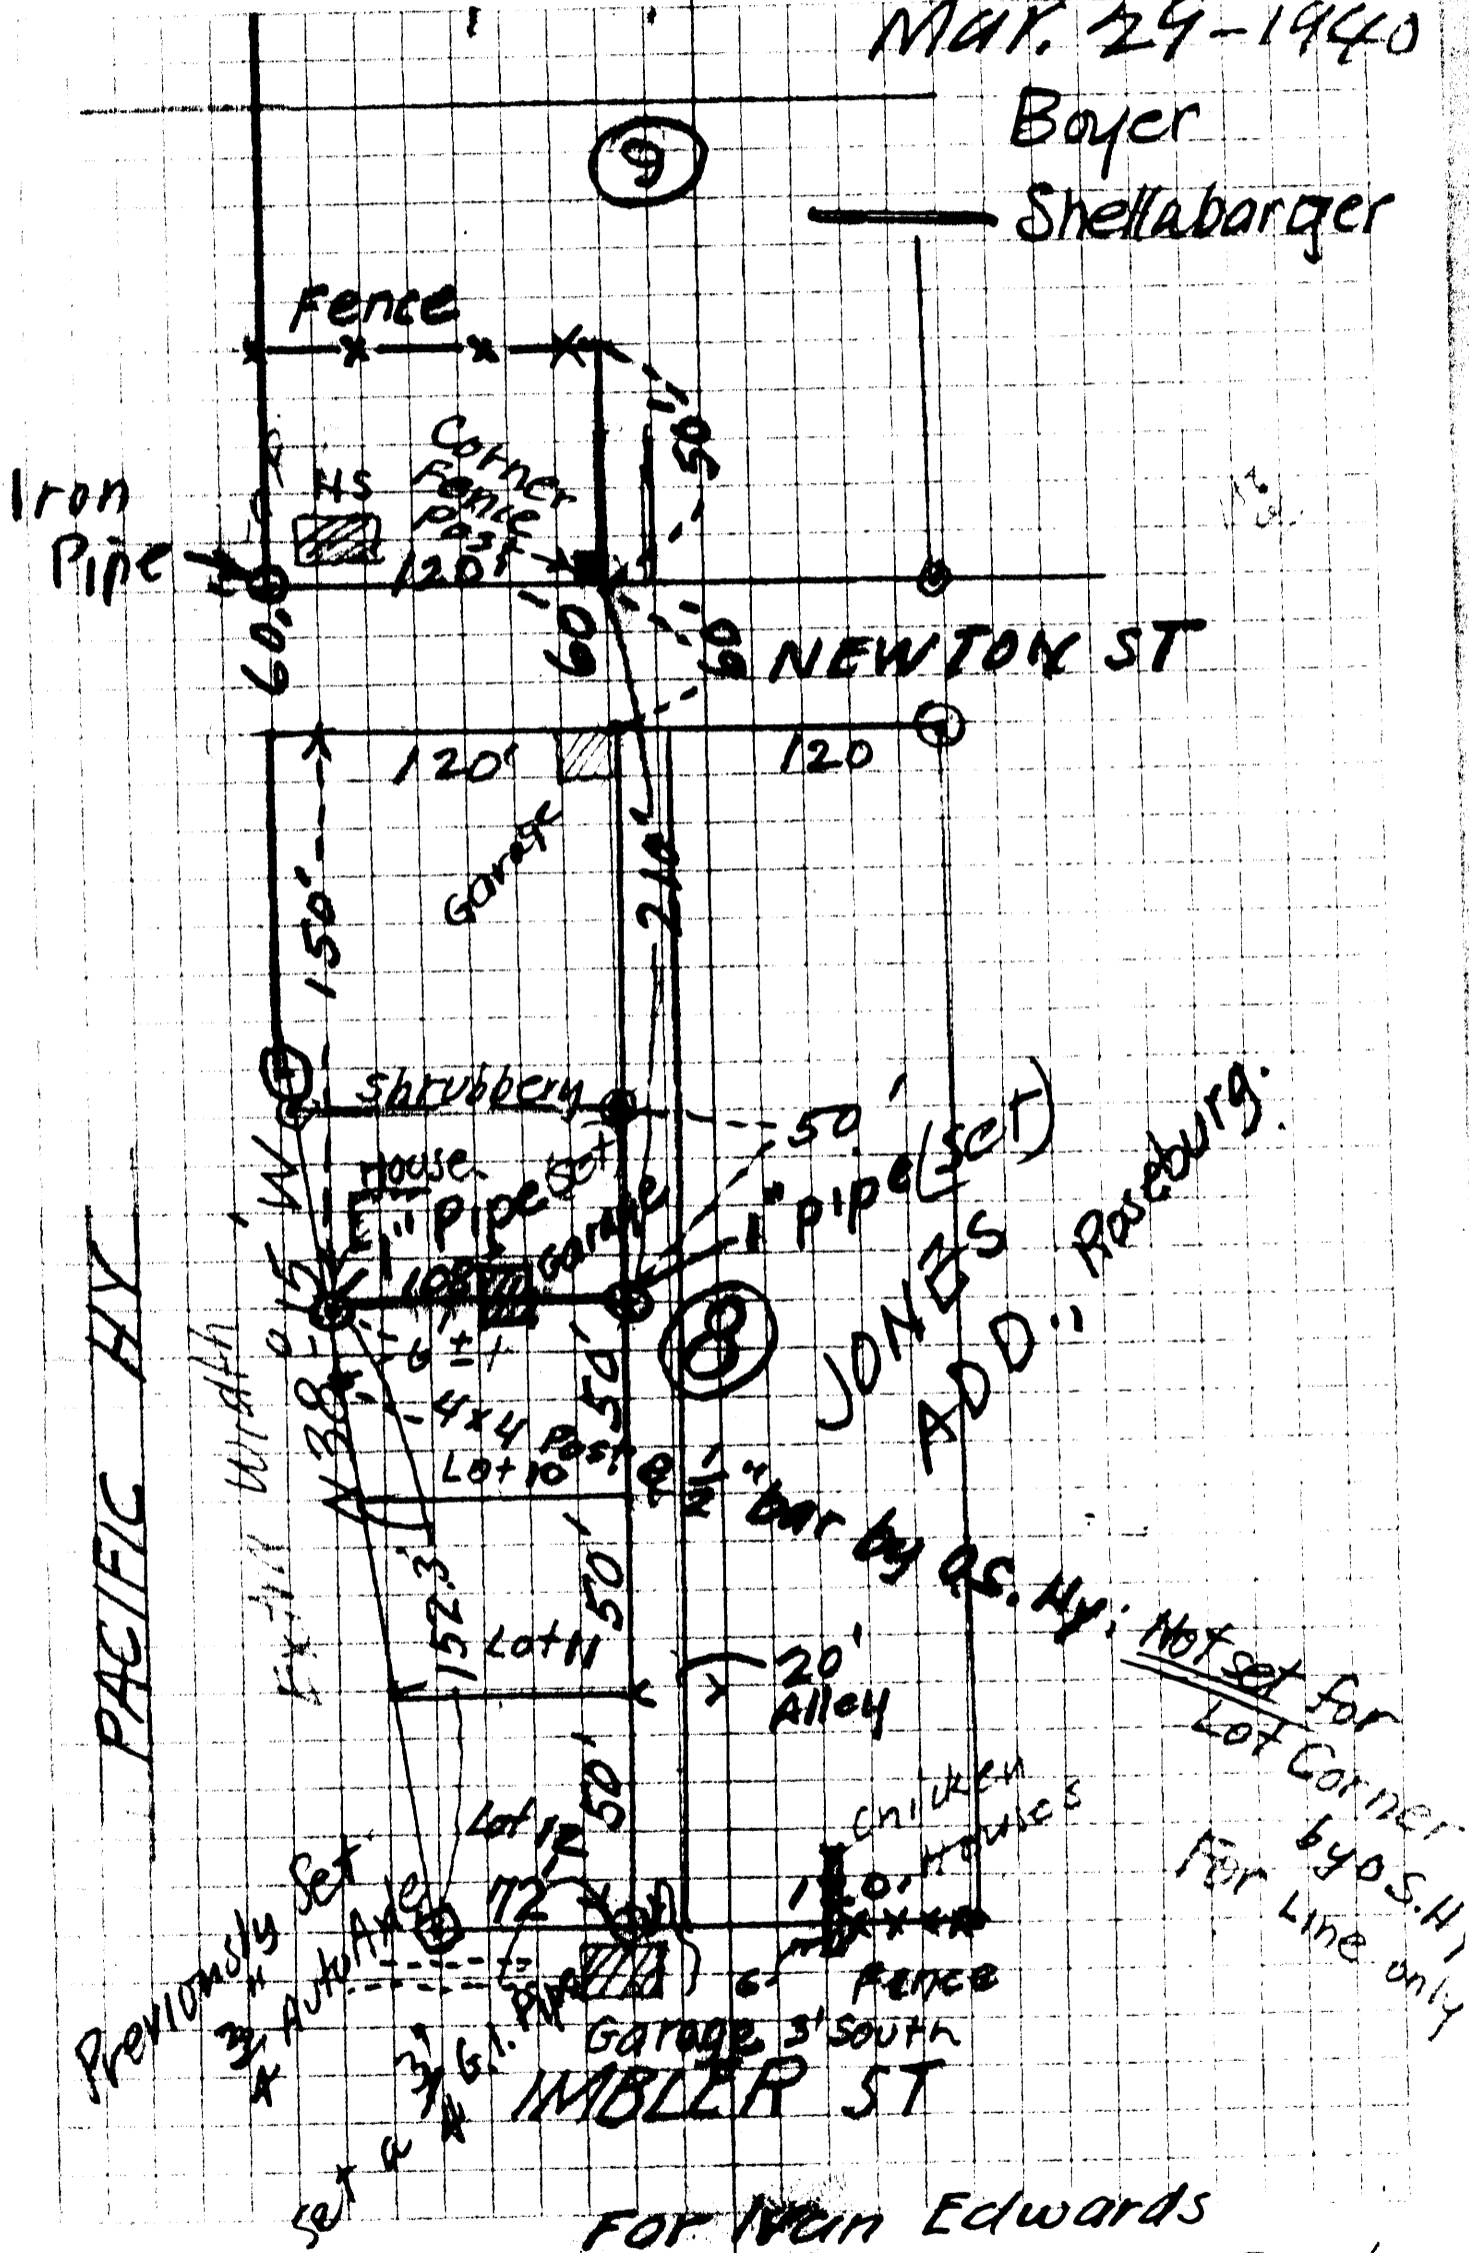

FOR Wain Edwards

P O.S. 16/62