

16-65

Wm Stewart

C. B. FILE No. 16/65



997  
300  
299.100  
985  
3  
295.5

128.5<sup>3</sup>  
970  
1249.50  
16065  
173,1450

124.7<sup>5</sup>  
.974  
4988  
8729  
11223  
121,4578

.981  
57.7  
6867  
981  
4905  
50,7177

101.6<sup>8</sup>  
792  
91446  
9144  
100,5846

299.1<sup>3</sup>  
295.5<sup>3</sup>  
173.1<sup>3</sup>  
121.4<sup>8</sup>  
50.7<sup>3</sup>  
137.0<sup>2</sup>  
1076.8

1320  
1077  
243  
10616  
142.4  
143.5

997  
144  
3988  
3988  
997  
43568

.656<sup>0</sup>  
997  
161<sup>0</sup>  
997  
5982  
997  
160.517

995  
3  
985  
119  
980  
9520  
1071

16 11 5 2 5 2 8 7 5  
298.5  
116.6  
41.5  
28.55  
701.0

415  
284.9  
699.9  
658  
43.


700  
95  
5

1435  
142.4  
1.1  
983  
201  
983  
1966  
197.583

total  
993  
3  
2979  
160.5  
458.4

2979  
160.5  
657  
197.6  
656

458.4  
197.6  
983)197.6  
1966  
1000  
983  
1770

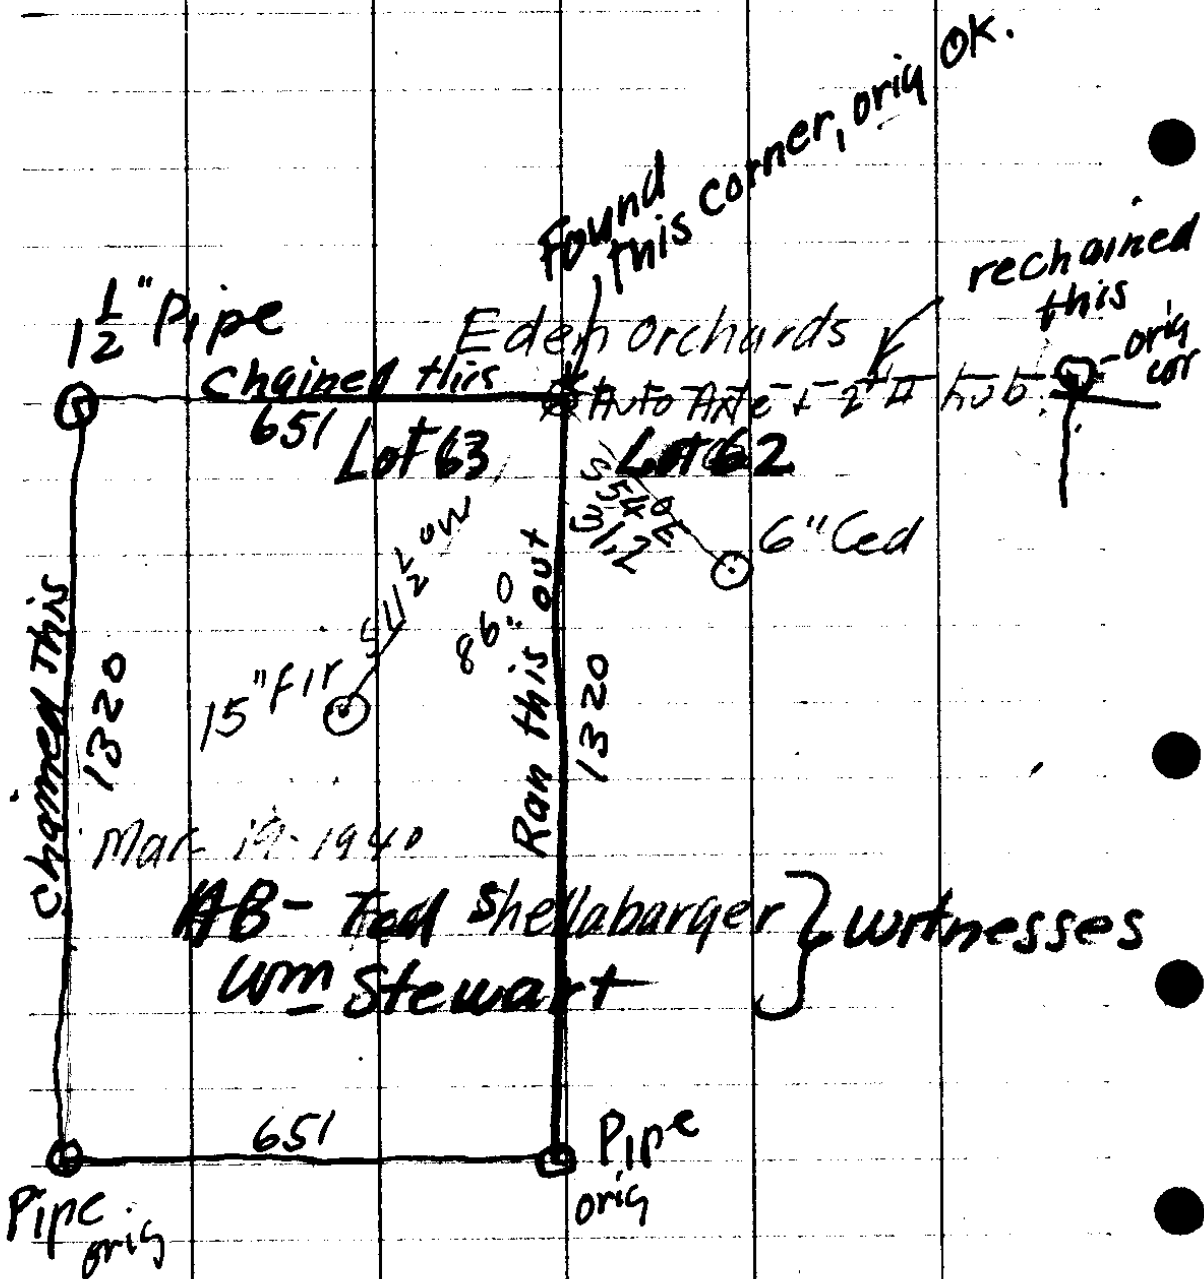

C. S. File No. 16/65