


Mar, 1940

16-6.6

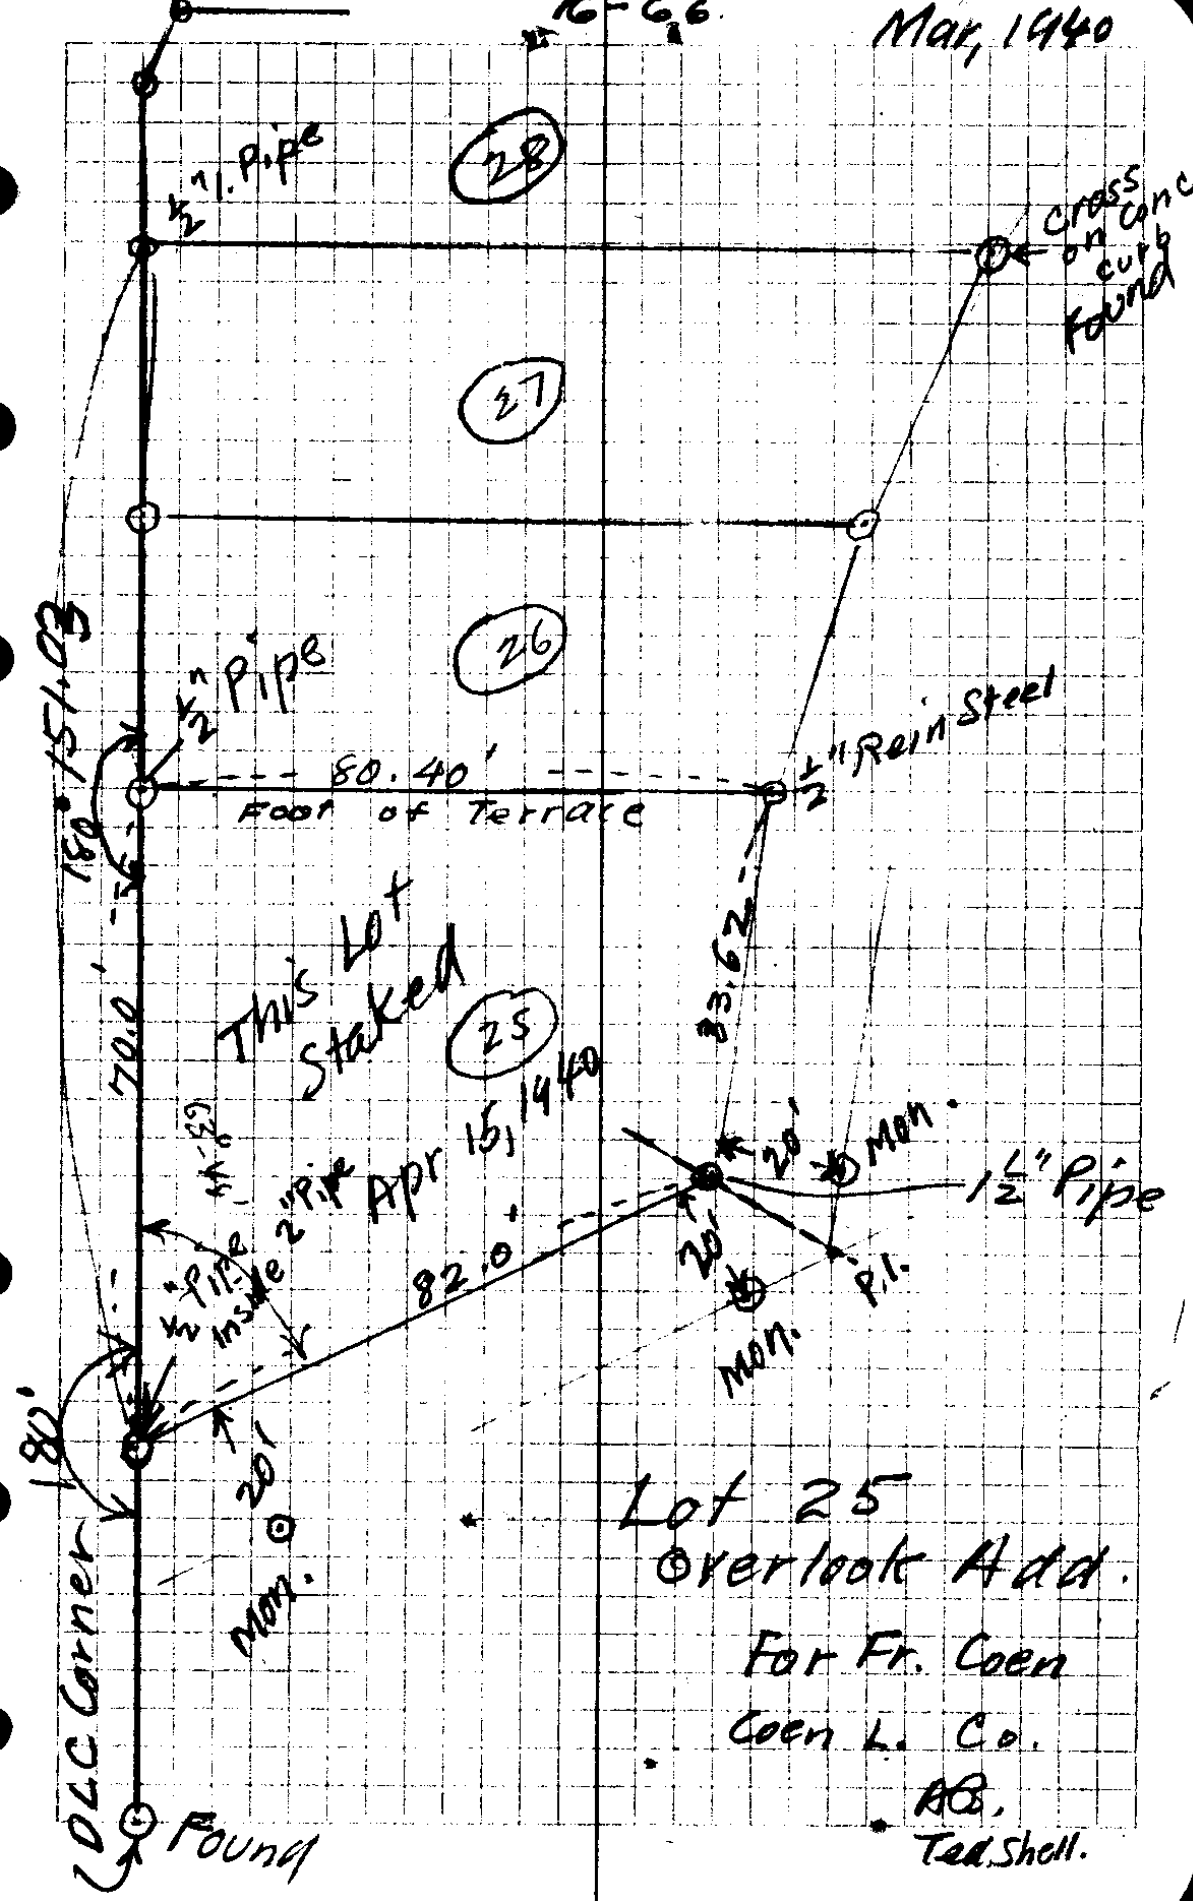

This Lot Staked

APR 15, 1940

Lot 25
Overlook Add.

For Fr. Coen
Coen L. Co.

AB.
Ted. Shell.