


Scale 2 in. = 1 Mile.

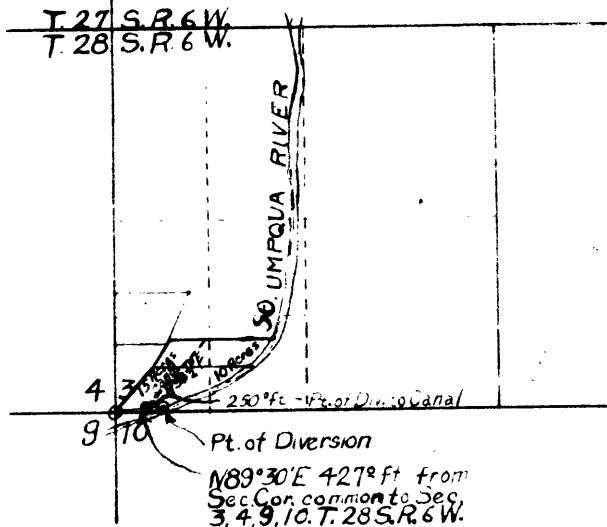

# MAP OF G.W. BURT IRRIGATION SYSTEM

IN

SEC. -- T. 28 S. R. 6 W. William. Mer.

DOUGLAS CO. ORE.

Office of EPPSTEIN & STEWART

APRIL 1923

**CERTIFICATE OF REGISTERED PROFESSIONAL ENGINEER**

I, H. L. EPPSTEIN, of Roseburg Oregon do hereby certify that this map was made from notes taken during an actual survey by me on April 14, 1923, and that it correctly represents the work described in the accompanying application, together with the location of streams and other ditches in the immediate vicinity.

*H. L. Epstein*  
Registered Professional Engr.

Oregon No. 1015

Nov. 8, 1920

Date of Registration

C. S. 17/1-2