


Pat 4-5-6-7 Feb 7. Laid out
 schedule. or. 160° in Bowler
 St. & running back to
 prop of Joseph Fitzhugh
 receipt ship of silver

~~Fitzhugh to Culver~~

Ray at pt. S 62° 30' E 135 1/2 from
 Bull on Chart 12, crangs / add
 S 62° 30' E 92 1/2; Ch S
 89° 00' E 51 3/4 Ch N 0° 28' E 80°
 Ch N 70° 16' E 161 8/5; Ch
 N 79° 56' W 46 1/2; Ch S
 27° 30' W, 232 1/2 ft

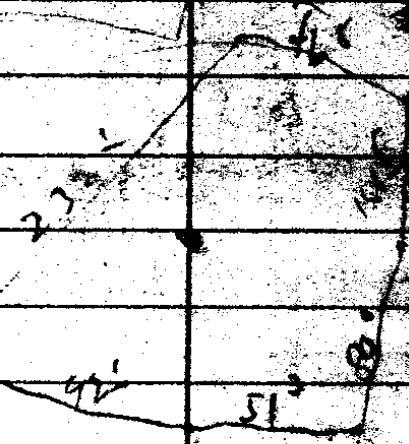

Patterson.

MW 1 ✓

Reset Mon. at Court st.

set Mon Main Court Mag.

site at on Court 664 3/8 S62°30'E

4°19' L def. 225⁷⁸ S69°E S66°49'E

1 81°14' L 162°29' 286⁹ N32°E N31°56'2"E

2 96°56' L 193 50 49⁷ N64°58'2"W

3 in Pats shed

17-10

C. S. File No. 17/10

F. F. Patterson.

set Mon. Count Fowler, site Mon Count to Elbst

Mon

90° 0' L

200⁰⁰

N 0° 32' E

#1

60° 57' L

88⁸²

N 60° 25' W

#2

22° 02' R

$$\begin{array}{r} 116 \\ 5745 \\ \hline 6905 \end{array}$$

N 38° 23' W

3

~~72° 54'~~
107° 06' L
87° 03'

1885

553° W

554° W

4

17/10

C.S. File No. 17/10