


17-17

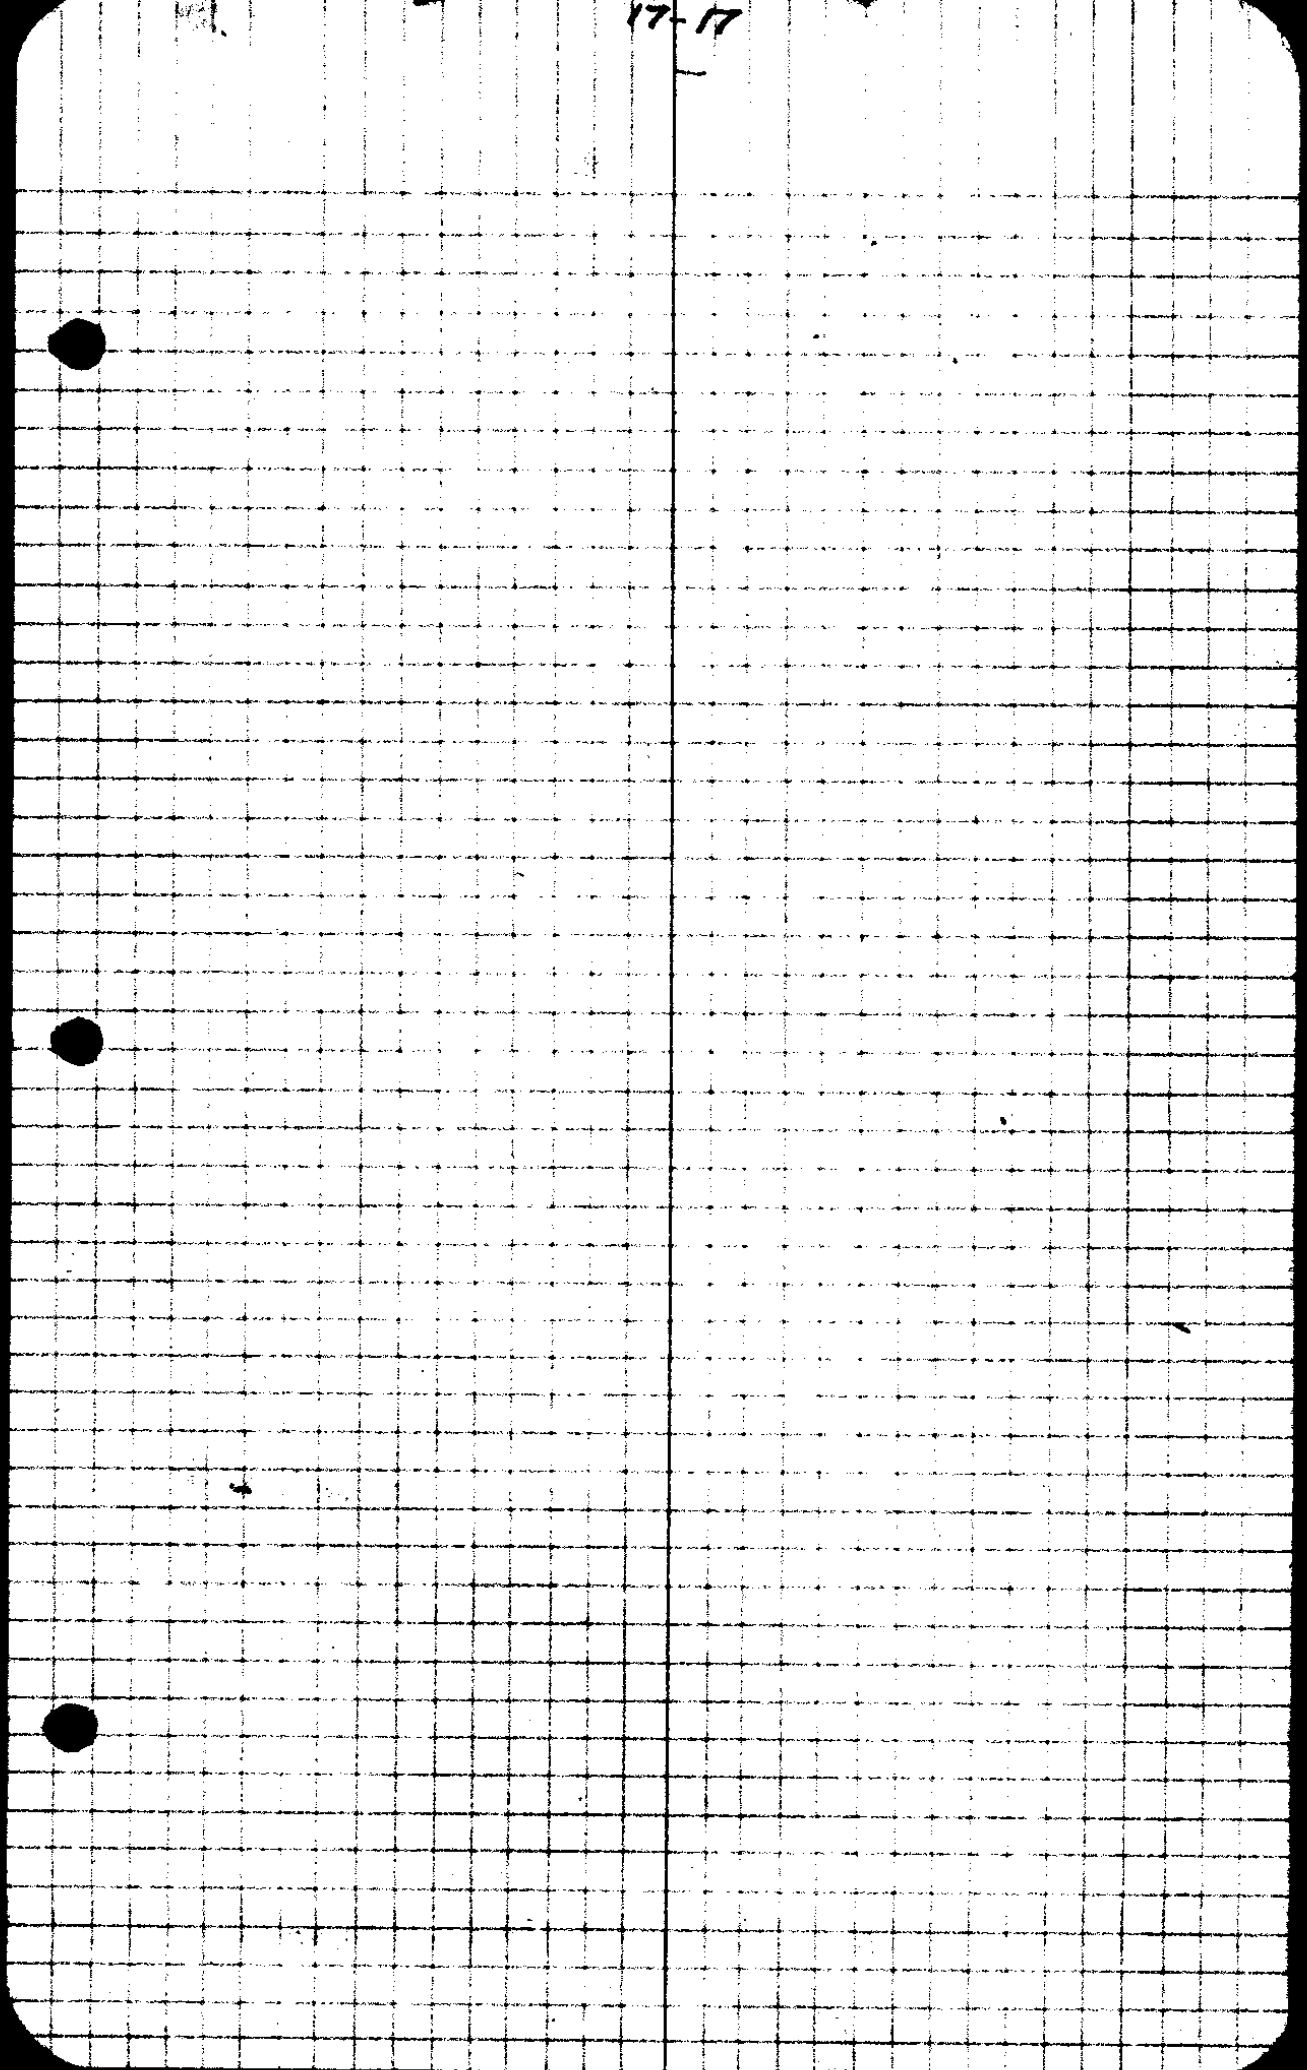

Sta Dist A West A Right MC

Δ 11 915² 7°-49 S 19-30E S 19-14E

Δ 10 419° 115-32 S 27-E S 27-03E

9 Δ 1874⁴ 75°-08 S 88W S 88-29N

8 Δ 731²

7 Δ 528⁰

6 Δ 484⁶

5 Δ 65³

4 Δ 474¹ 3198⁴

3 Δ 205⁵

2 Δ 246⁹

1 Δ POT. 403²

S. E. Co. N 17° W N 16-23 W

● 100 feet West.

↳ 50 west

20 feet to bank west on E & W line


26 feet North of line

Sta DIST A W A R M.C.

Δ 1		106-23		N 17 W	N 16-23 W
SE Cor	12 15 ^E	39°-34		East	East
Δ 15	452 ^E	26°-53'	3	S 50-15 E	S 50-26 E
Δ 14	789 ^S		29-18	S 24 E	S 23-33 E
Δ 13	424 ^E	46°-59		S 53-E	S 52-51 E
Δ 12	451 ^E		13°-22'	S 6°-45 E	S 5°-52' E
Δ 11					S 19-14 E

on Jones st. let by street. from this
go west ^{9000 ft} 1000² to river bank
close to station Δ12.

50 West River

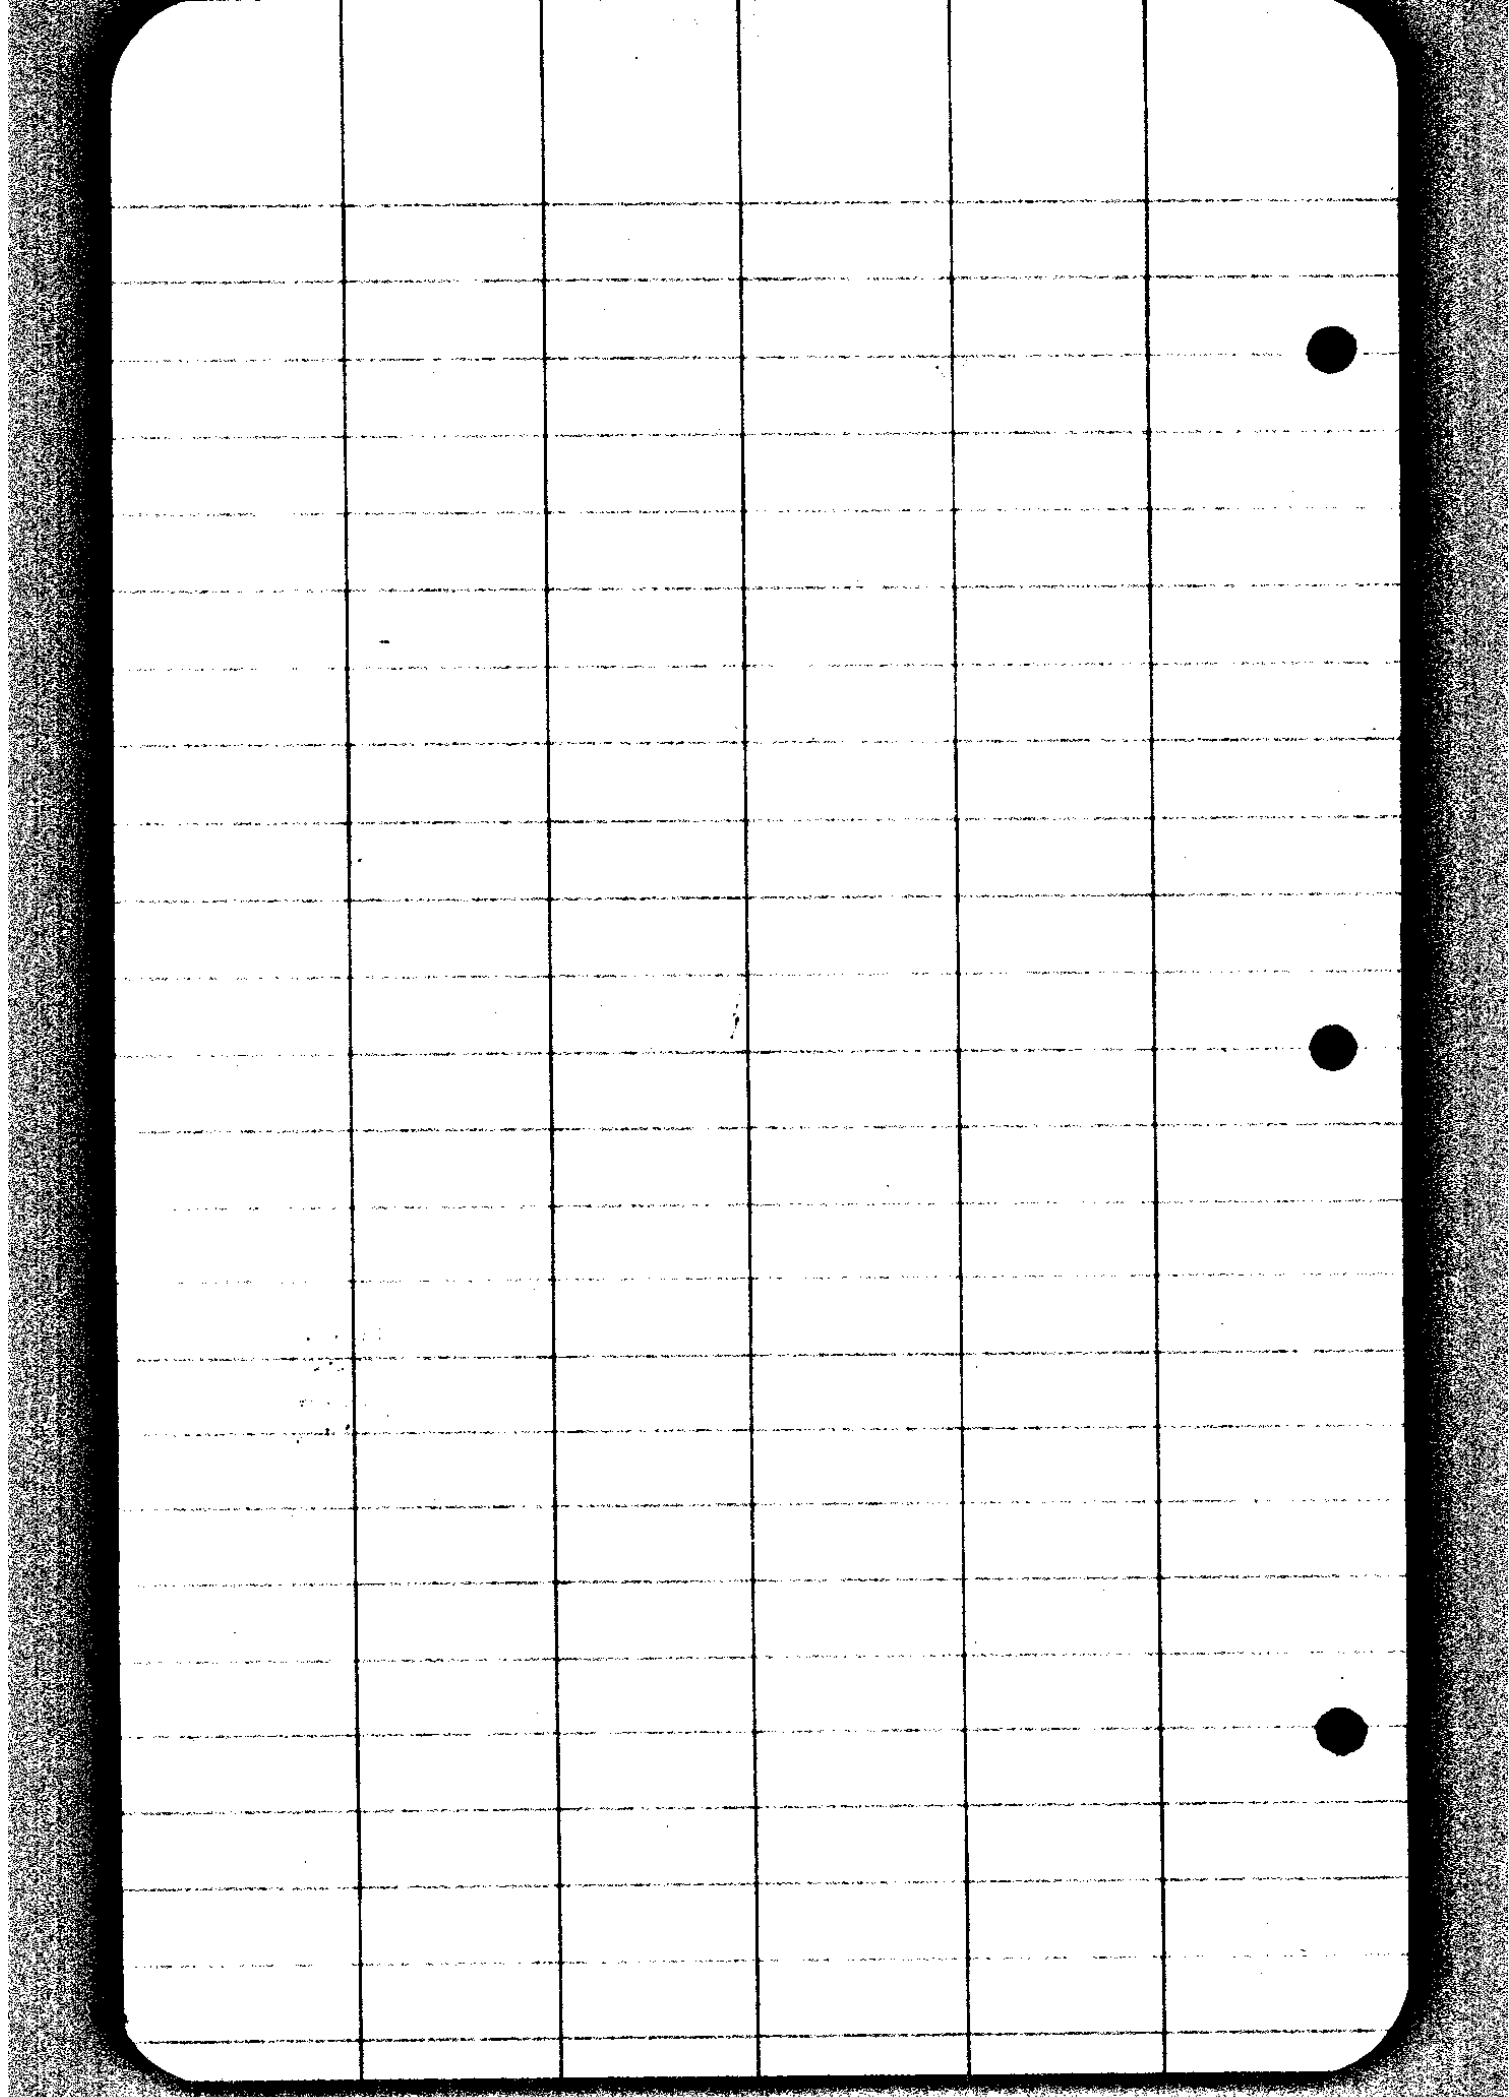

CS FILE FOLDER

CONTAINS

MORE

INFORMATION