


27-6

Wagner C155

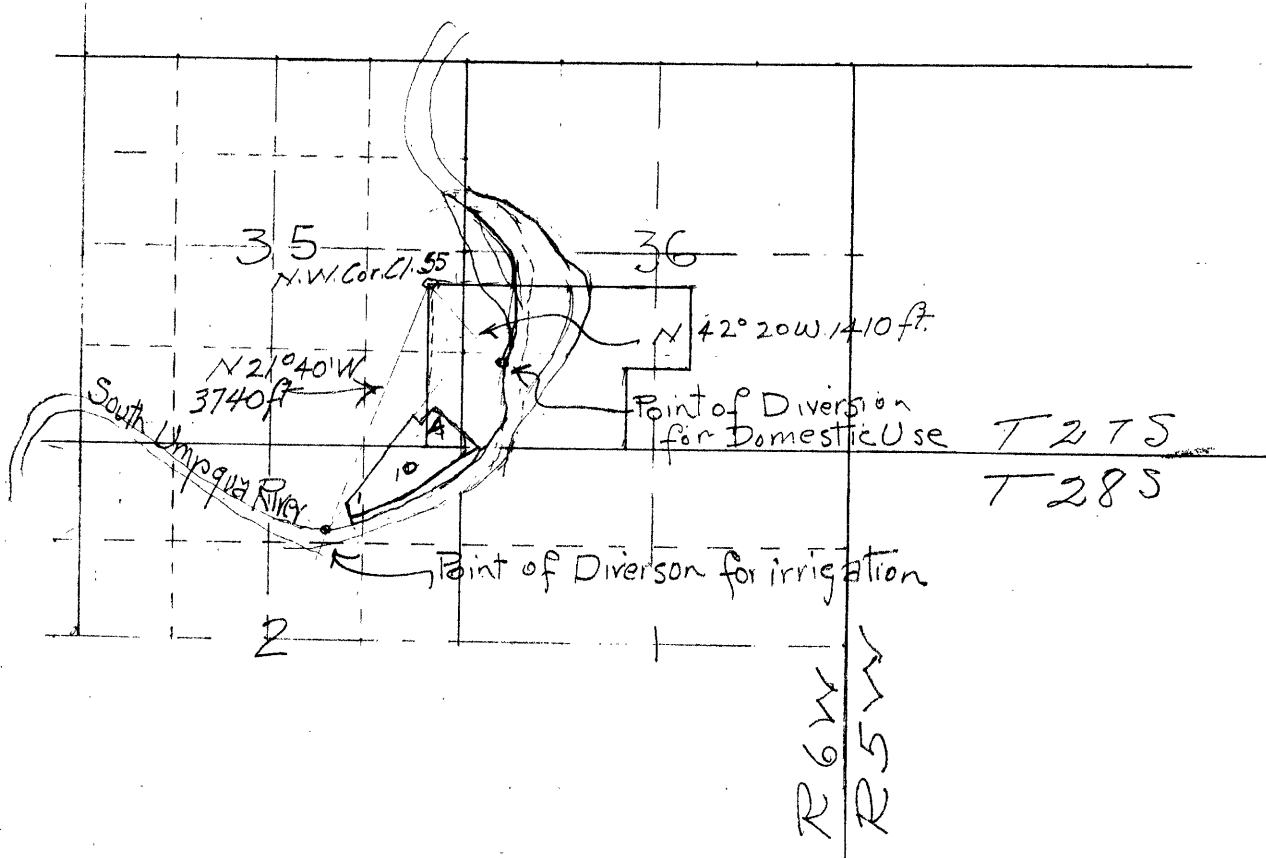

(CAMPBELL)

C.S. File No 17/19B-21