


18
25

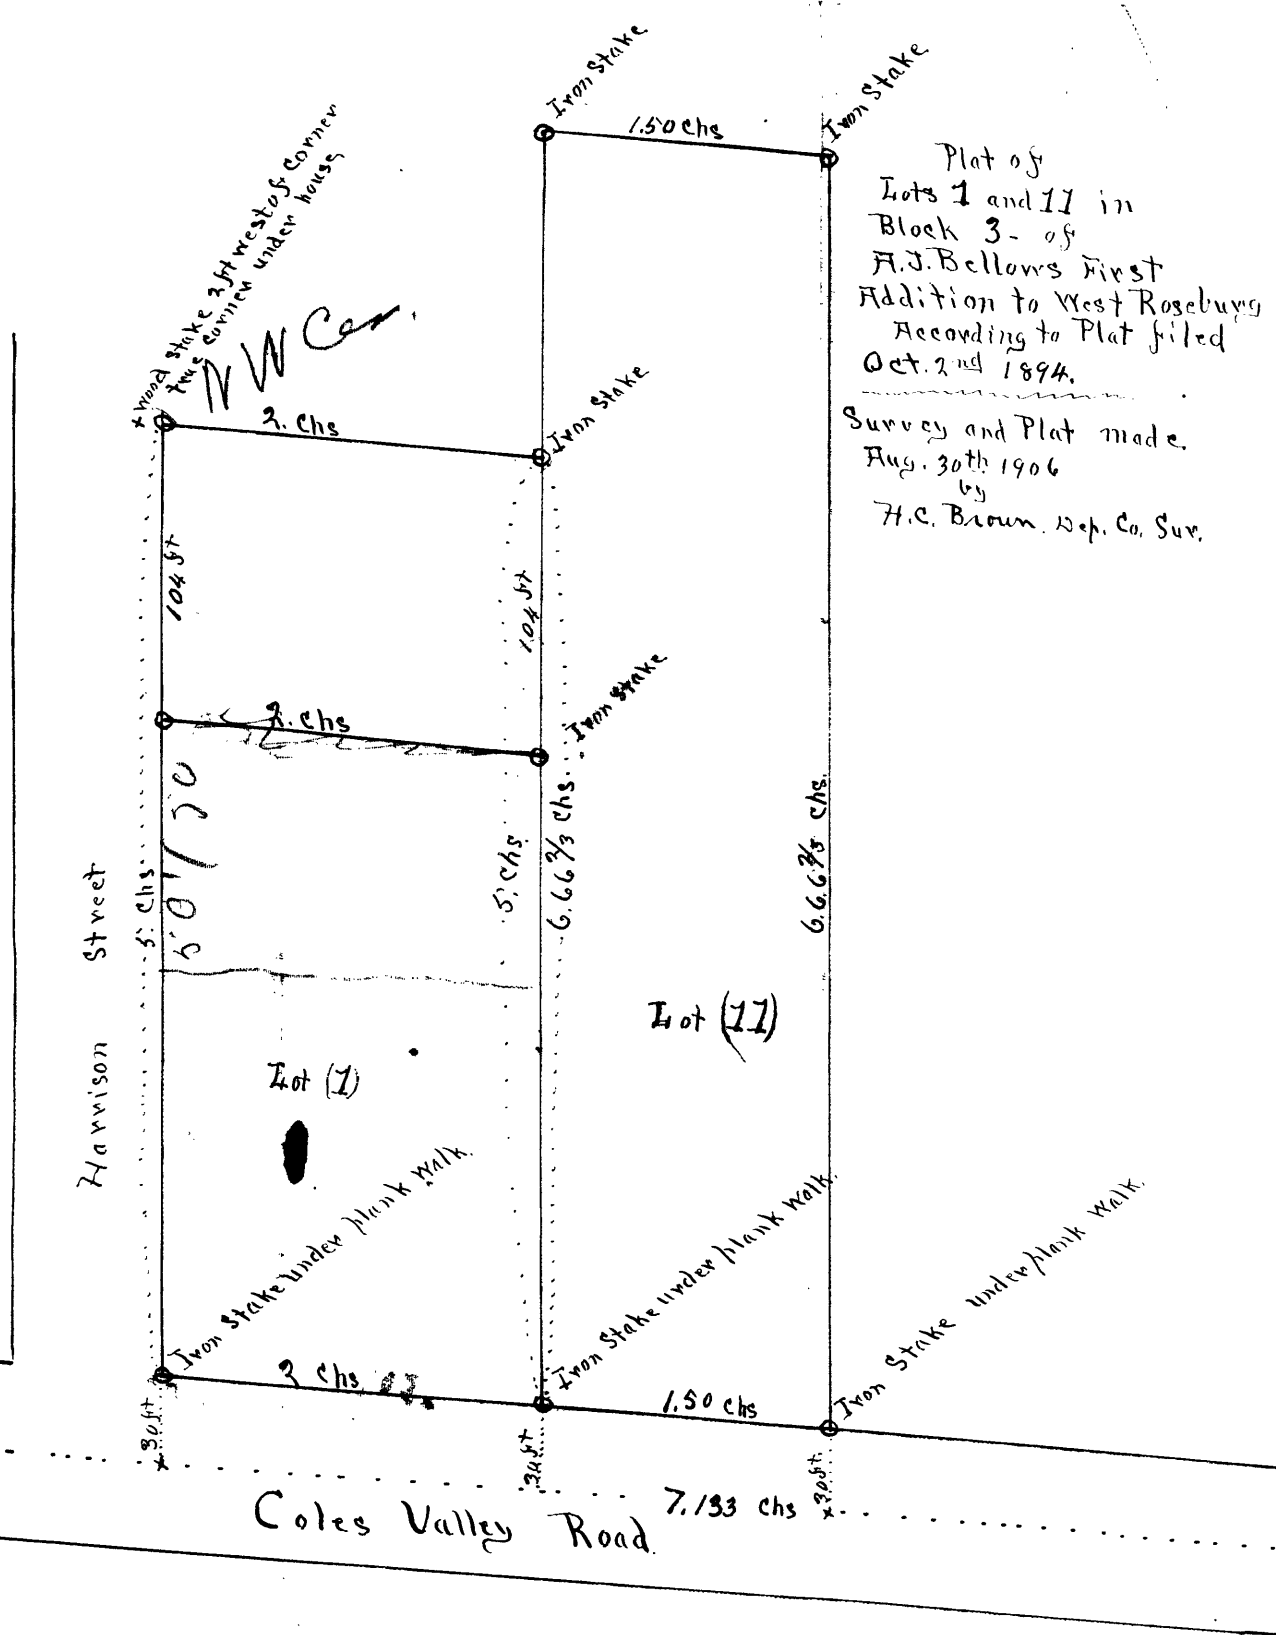

Plat of
 Lots 1 and 11 in
 Block 3- of
 A.J. Bellows First
 Addition to West Roseburg
 According to Plat filed
 Oct. 2nd 1894.

Survey and Plat made
 Aug. 30th 1906
 by
 H.C. Brown, Dep. Co. Sur.

Iron Stake in Center of
 Coles Valley Road and
 Spring St. described in original
 Plat.