

USVS
New Soldiers Home

Elev of E. B.M.

DEC 1933

60.7 feet
from Peg
Tandy Home
54 feet

446.299

NW Cor of Head Wall at Culvert.

West Basement Window Tandy Home

Flow Line Little Pipe 440.866
440.87

Top Big Pipe, Bottom 440.098
440.70

" Little " , AT House 440.937


Basement Floor.

First Floor.

6:15 PM

McKenzie called up and wanted to

know whether or not you had this work done.

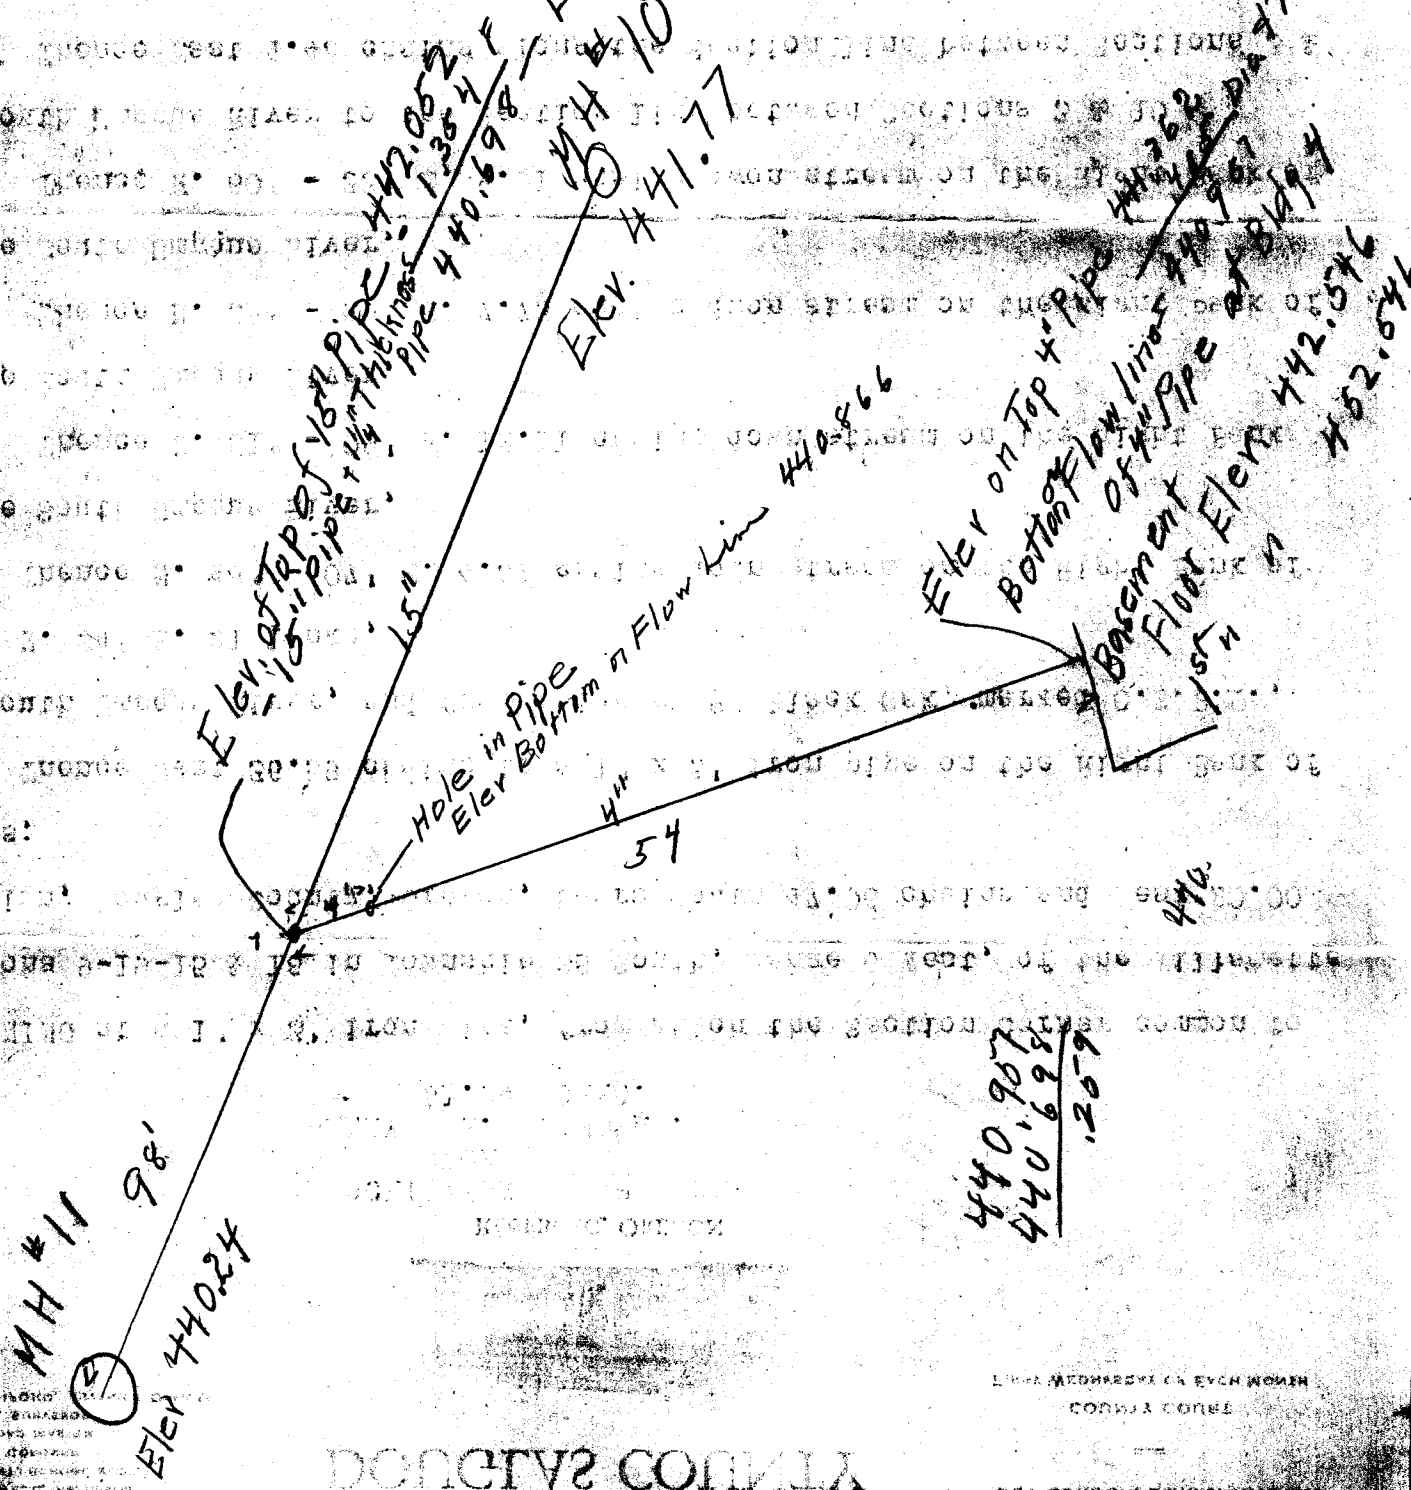

440.967
440.698
269

DOUGLAS COMPANY

DOUGLAS COMPANY

DOUGLAS COMPANY

CS FILE FOLDER

CONTAINS

MORE

INFORMATION