


18-46

Feb. 28-1934

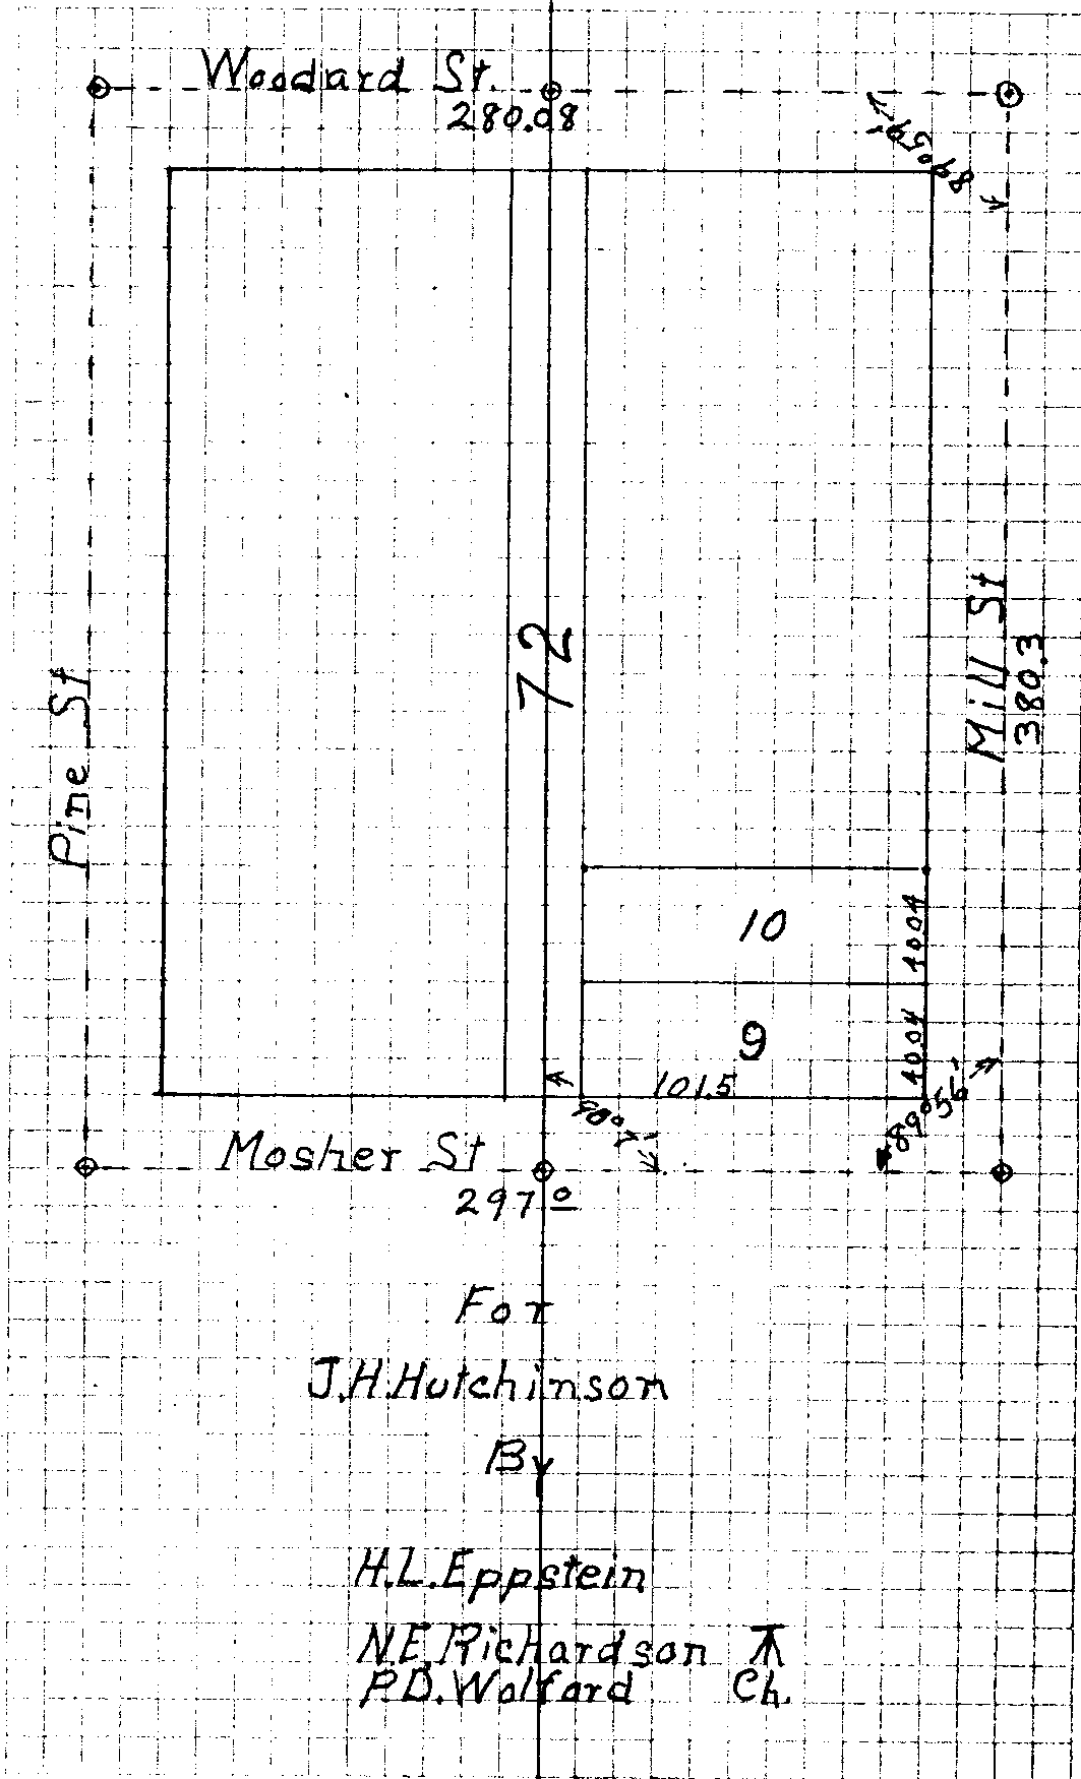

Moshier St
297.0

Lot
J.H. Hutchinson

By

H.L. Eppstein

NE Richardson T
PD. Wolfard Ch.

P