


SURVEY FOR
DOUGLAS CO. CREAMERY

Feb 21, 1934

Eppstein
Wolkord
Richardson

LOTS 10-11 BLK 18

1/2 Day

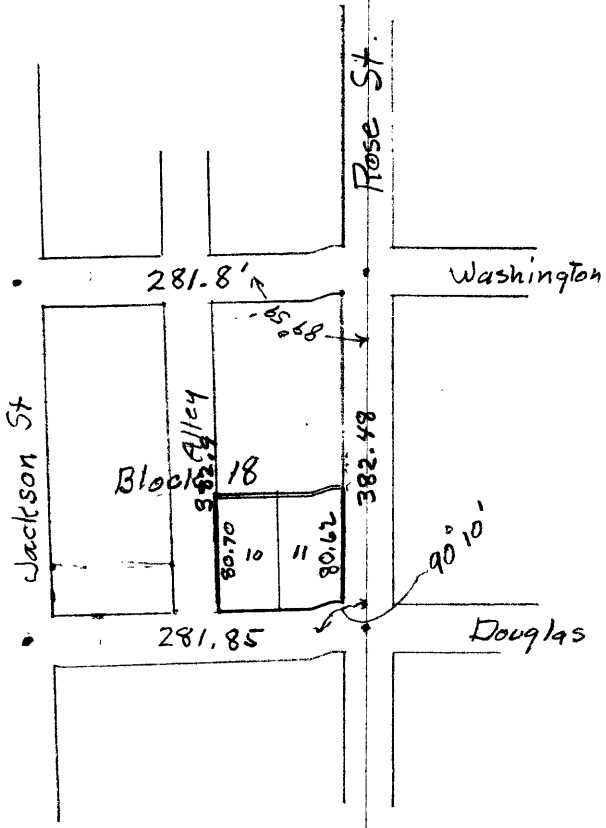

Set Iron Bars or Pipe at
all four corners of Property