


MAP OF

A. E. Rutter's Land

1 IN

Sec. 12 T. 27 S., R. 6 W. W. M.

Scale 1" = 50'

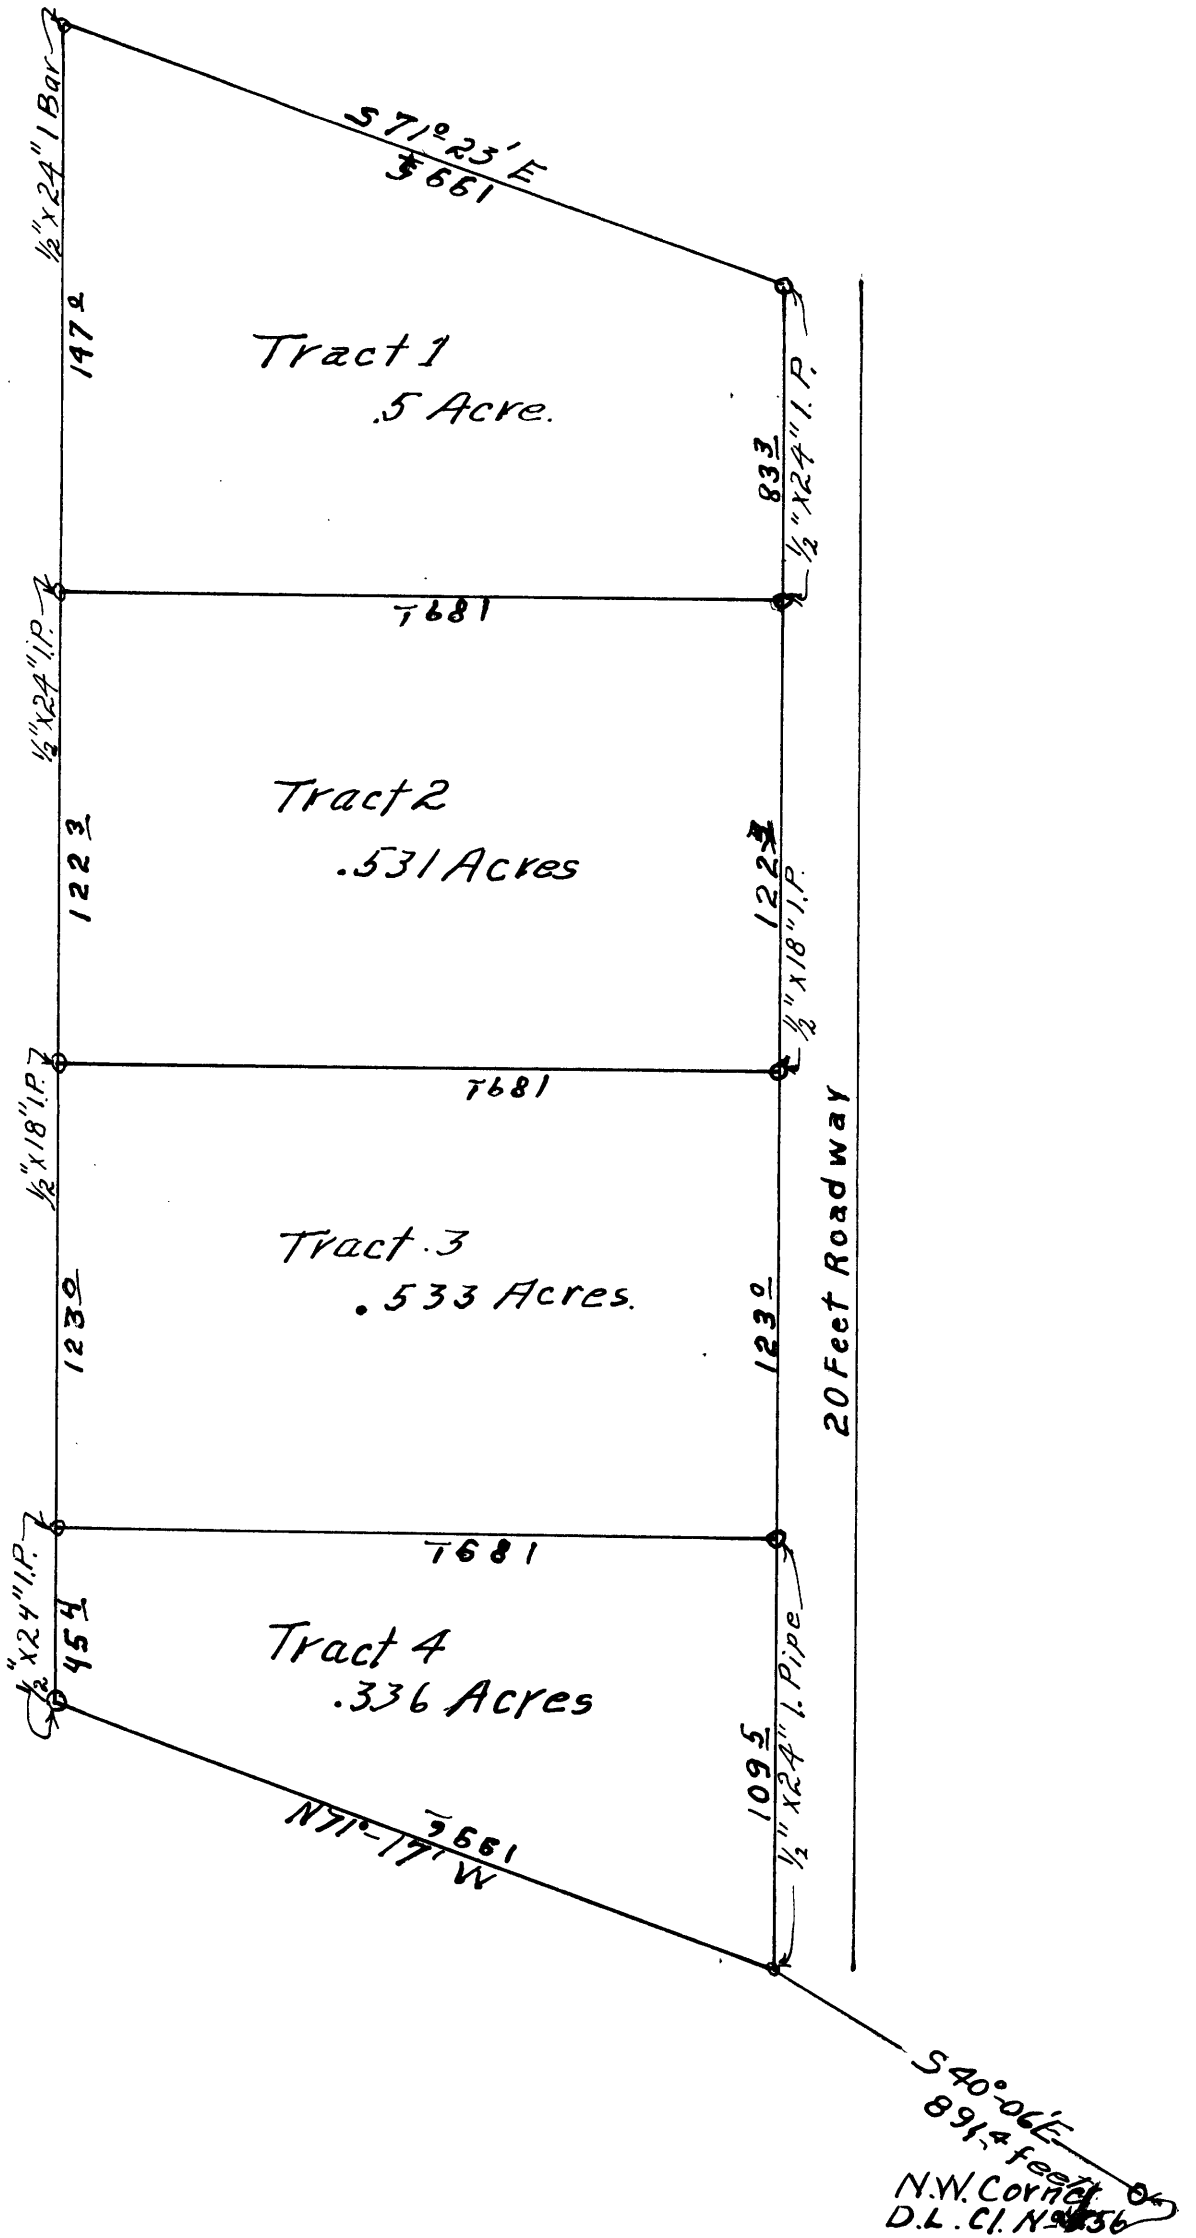

A E Rutter

Feb 25, 1935

H.L. Eppstein

N.E. Richardson

B.A. Lane

108037'

1/2" x 24" Iron Bar

1995
N 69° W

1/2" x 24" Iron Pipe

1/2" x 24" Iron Pipe

189 1/2

1/2" x 24" Iron Pipe

14' 0 1/2 set

1/2" x 18" I.P.

189 1/2

14' 0 5/8 set

1/2" x 24" I.P.

189 1/2

1/2" x 24" I.P.

187° 15'

1/2" x 24" I.P.

1/2" x 24" I.P.

171° 21'

T27 R6W

MW Cor

CL 56

5248

578-39 E

436.45


1223

1229

454

55-54 E
5810

107 1/2

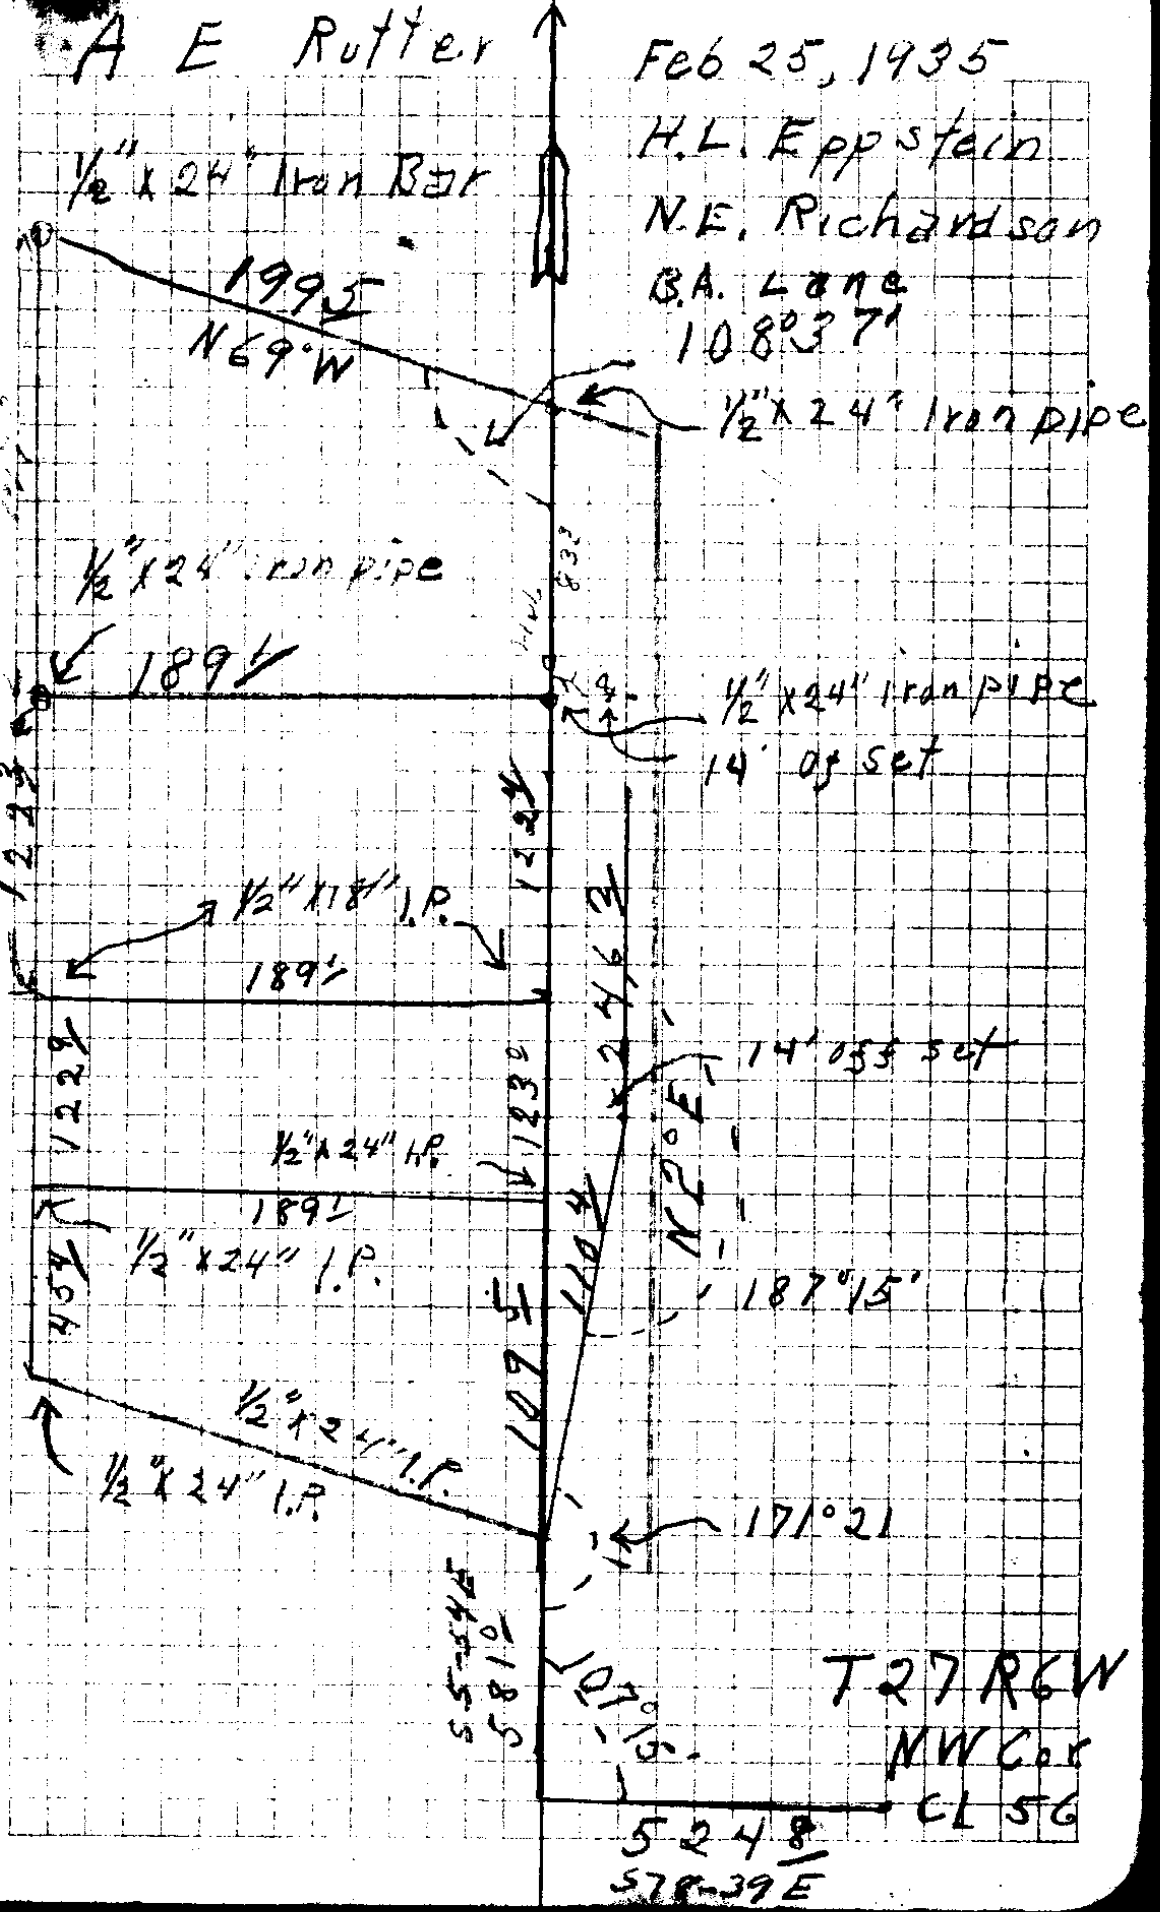

CS FILE FOLDER

CONTAINS

MORE

INFORMATION