

# MAP OF LOT 1 BLOCK "B"


IN 'UMPQUA PARK

Scale 1 in = 200 ft.

Surveyed for W.F. Kernin to determine South boundary of Lot 1. March 1, 1915.

F.J. COLE dep. Surveyor.

W.F. Kernin  
Map of Lot 1

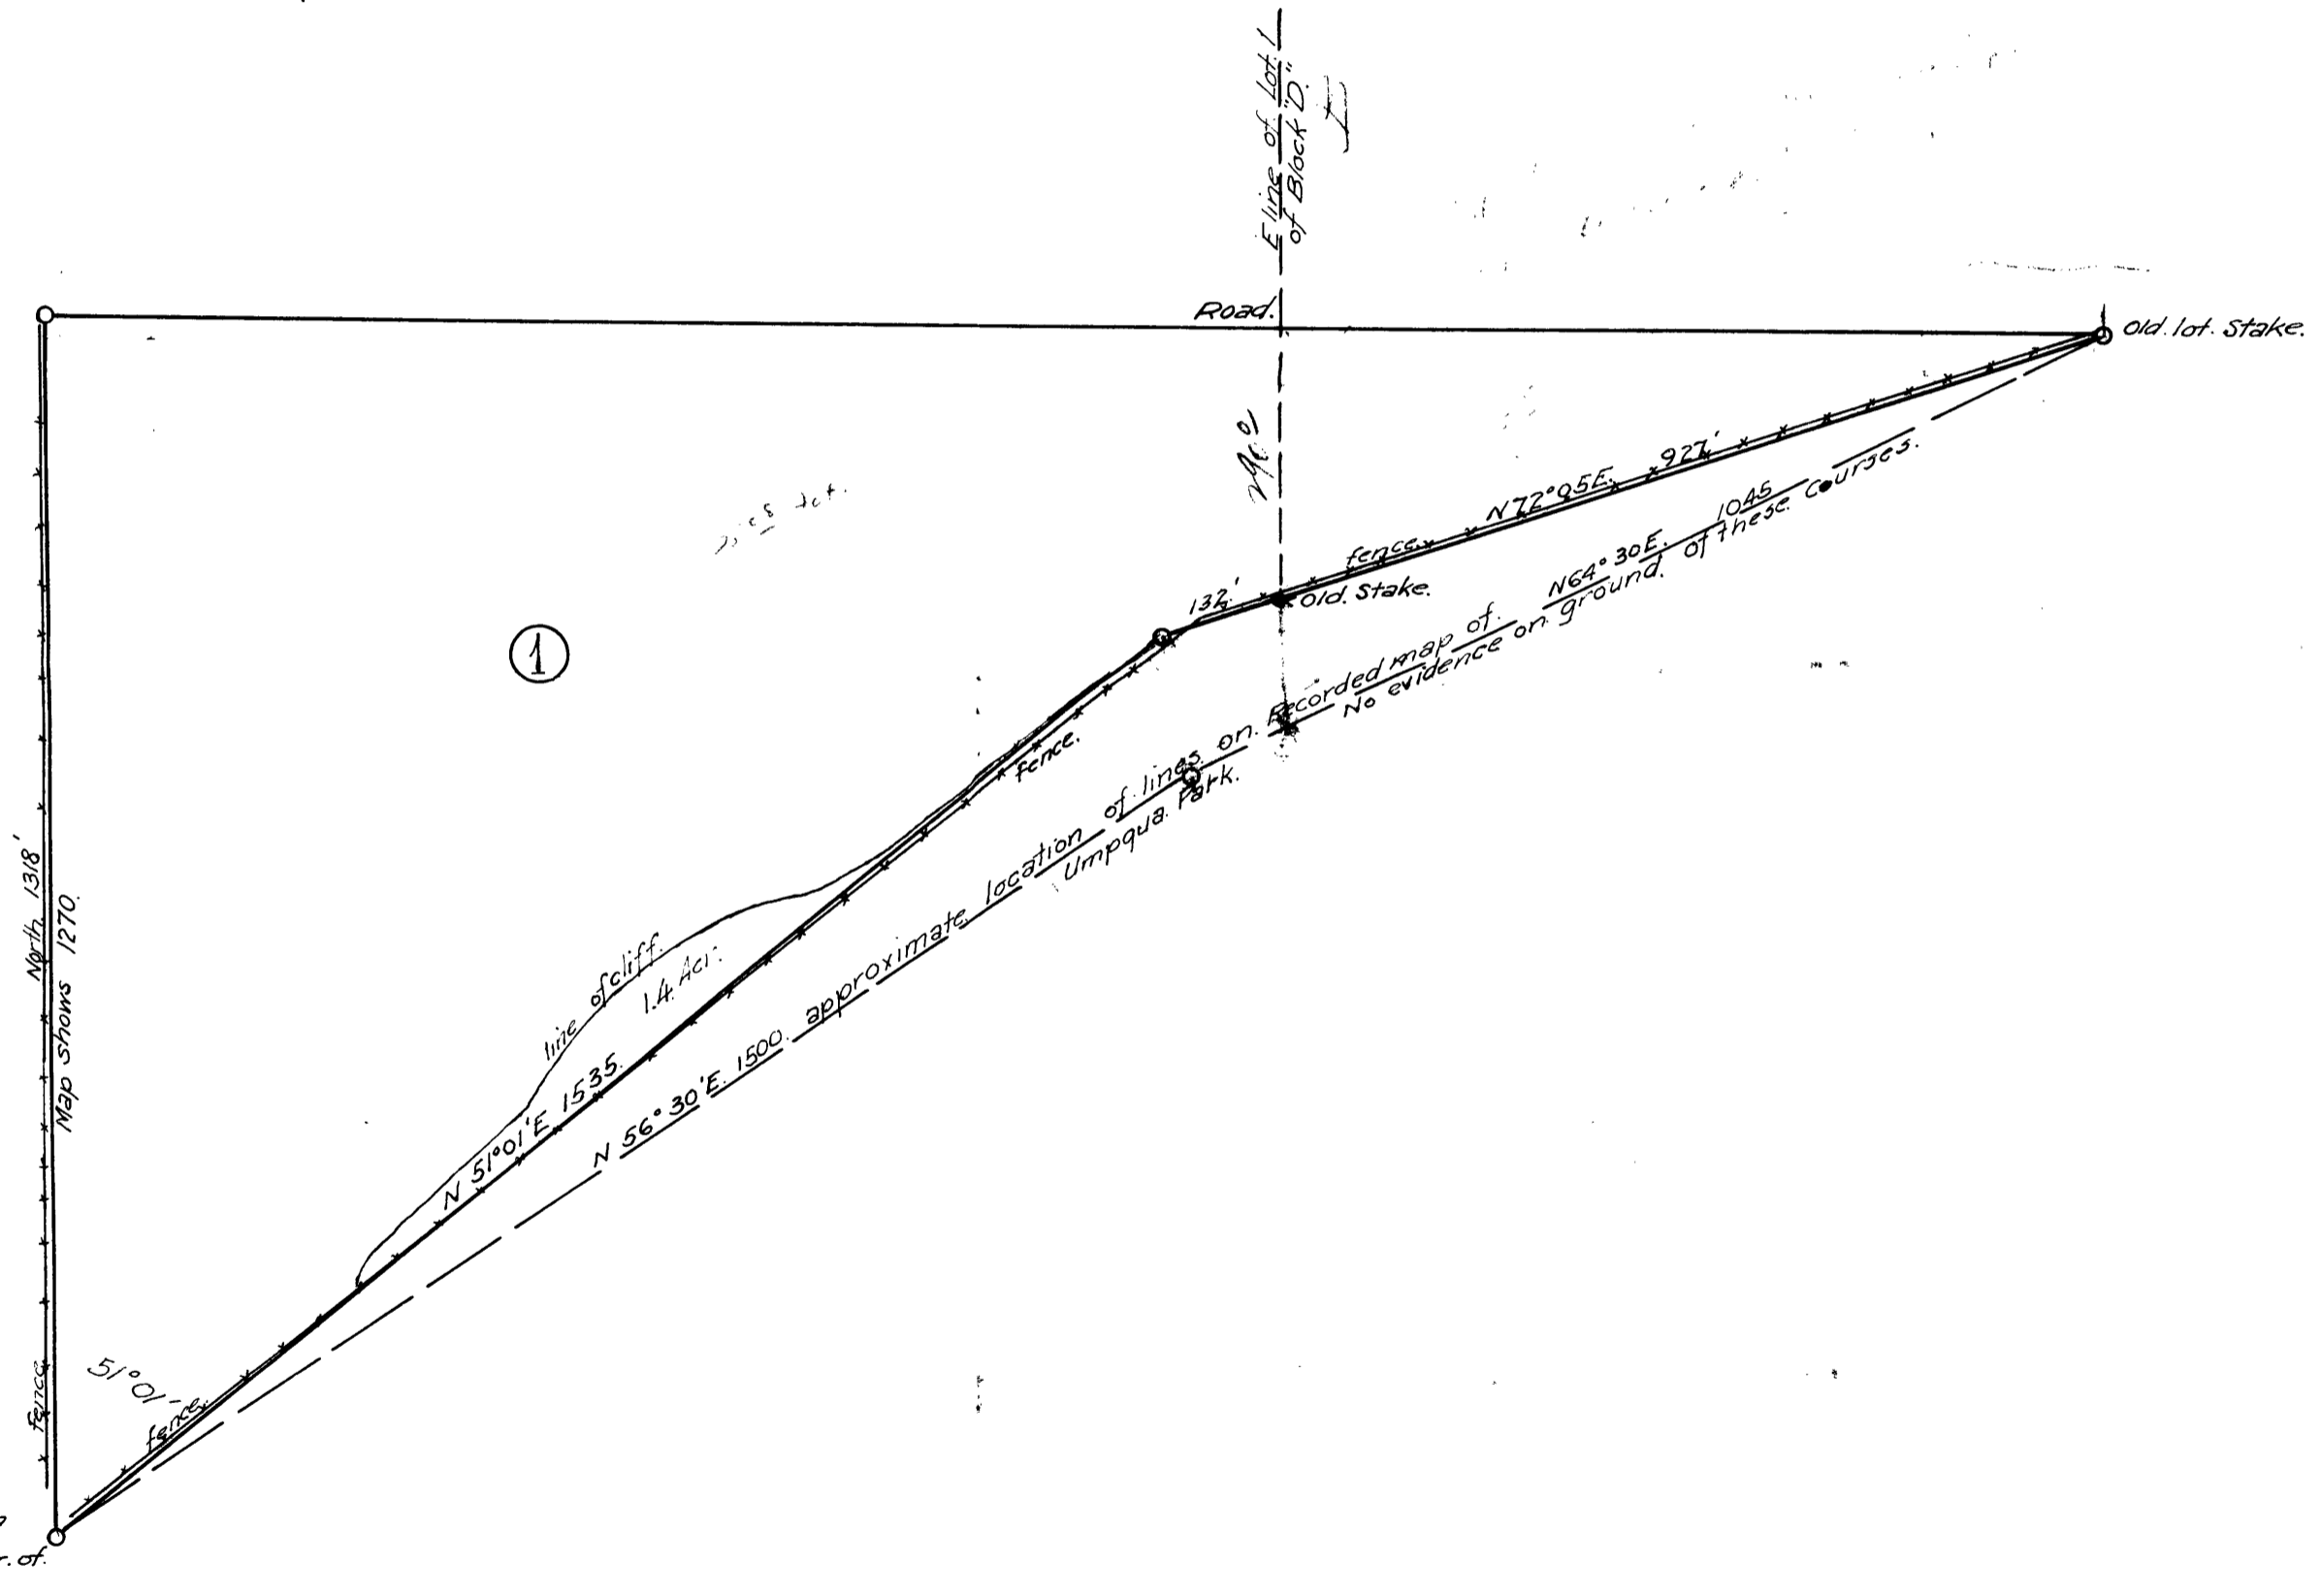

CS FILE FOLDER

CONTAINS

MORE

INFORMATION