


Lot Survey Lot 2  
 Green Sta  
 For Miles  
 July 9, 1935

19/14

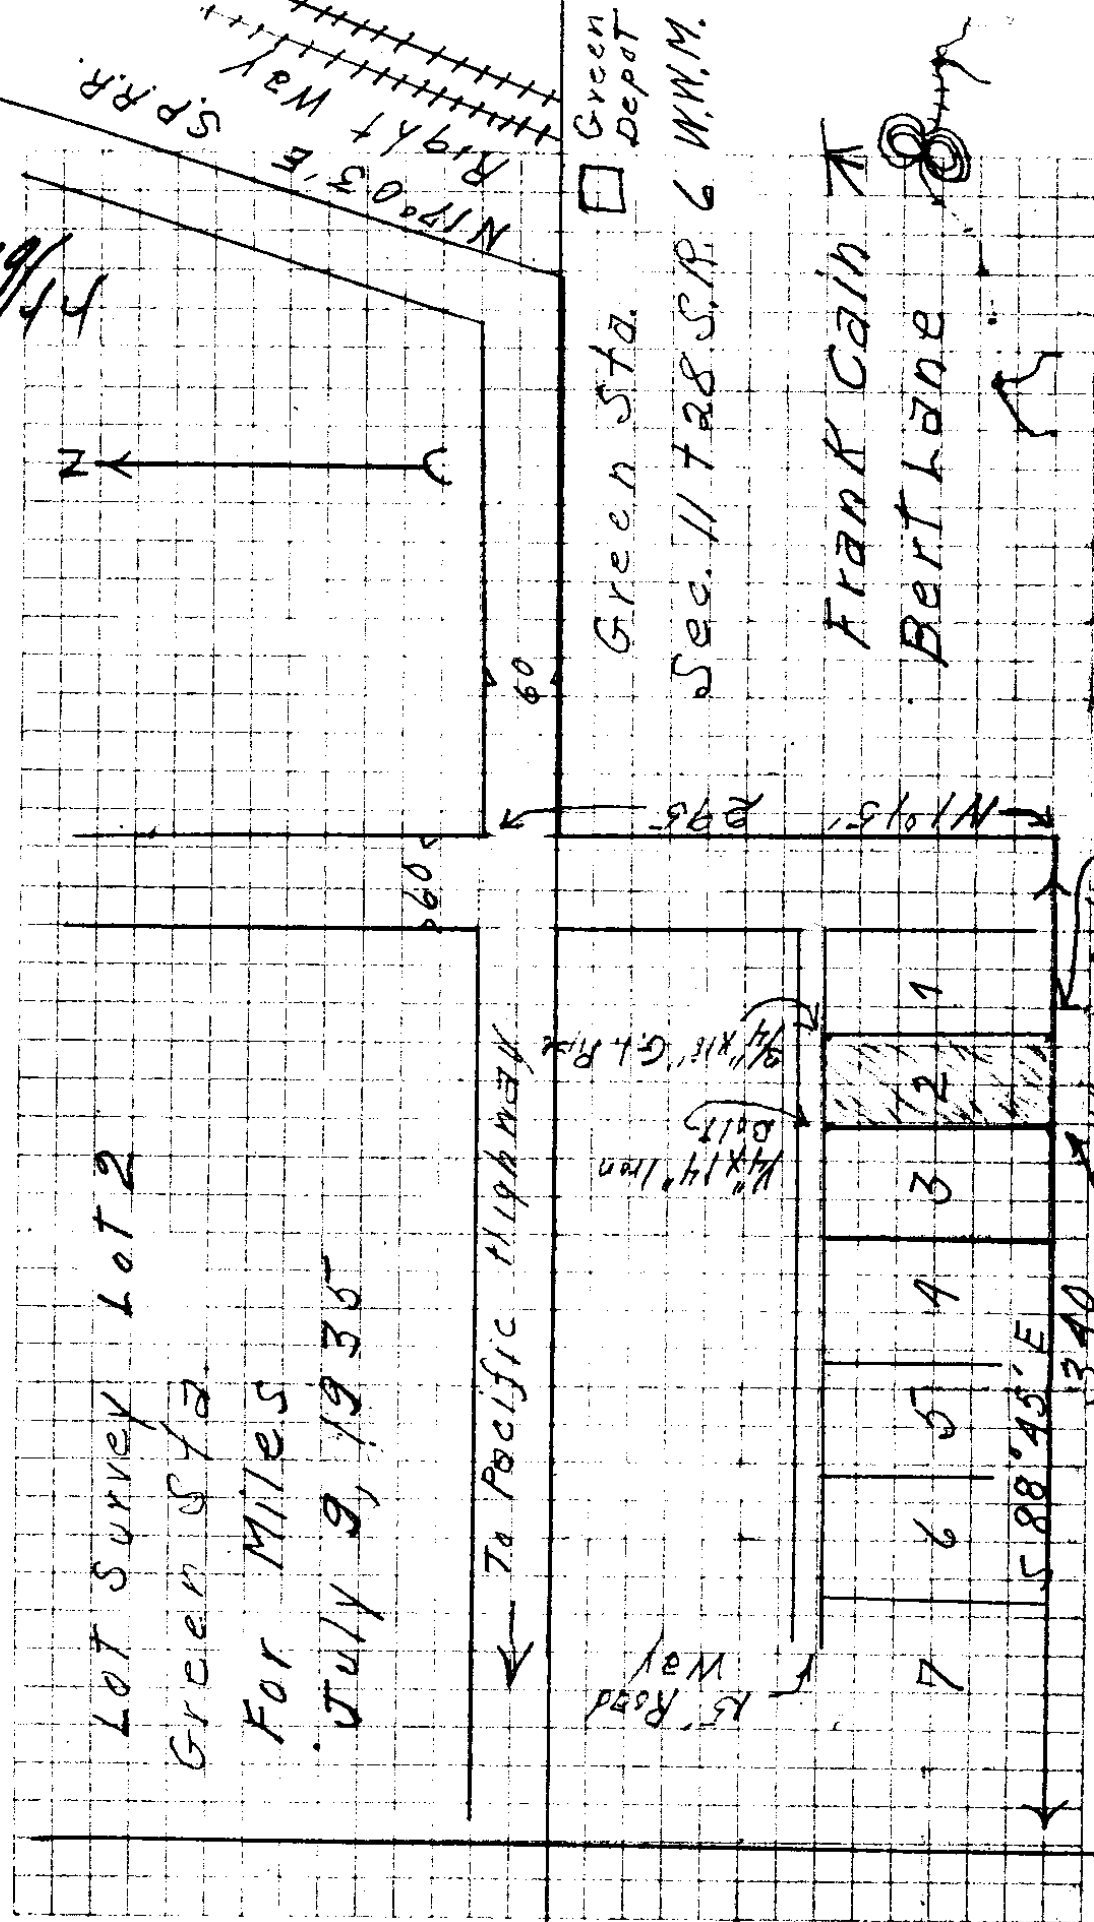

19-44