


Dr. Wade

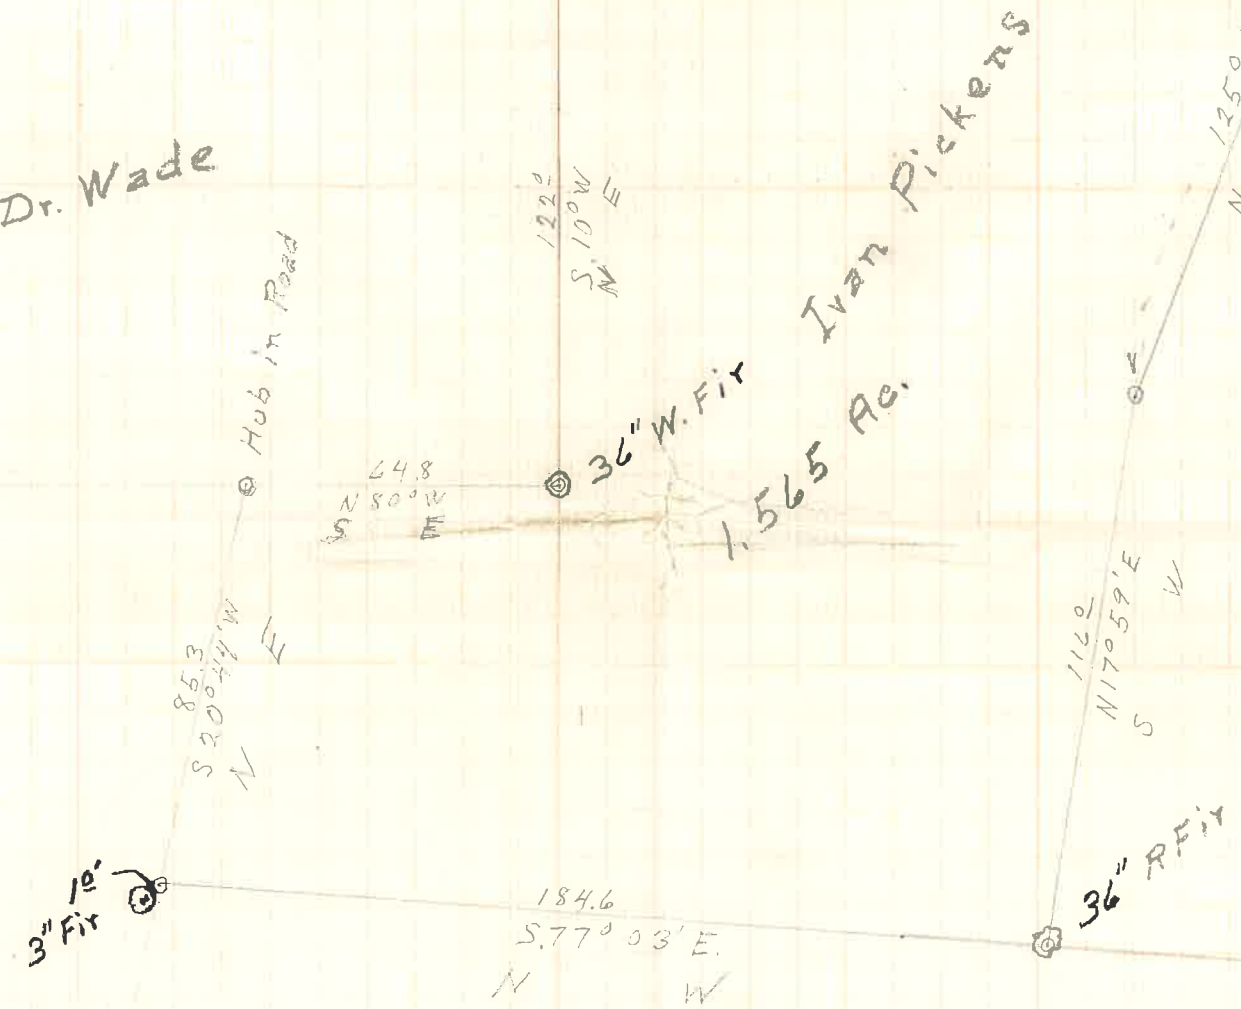

CS FILE FOLDER

CONTAINS

MORE

INFORMATION