



T295 R6W
 Nat 43005'01"

12
 18.00
 21.60
 29.90
 36.10

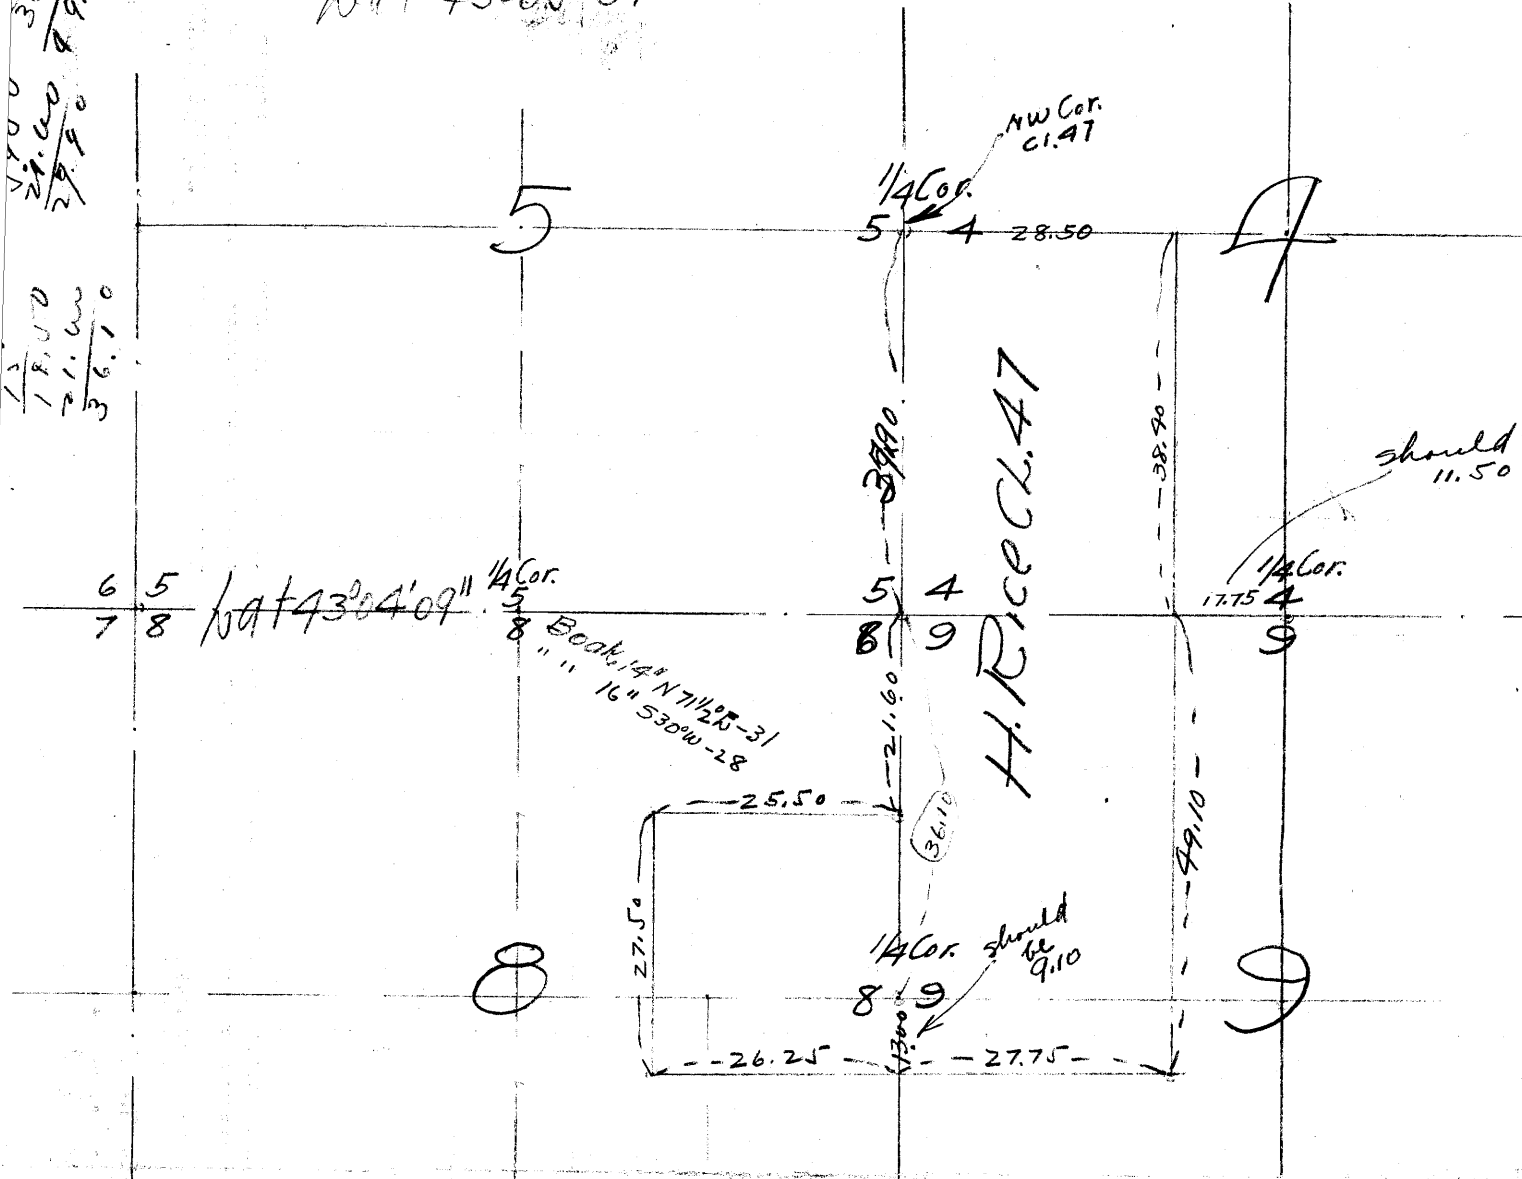

R.E. Horness

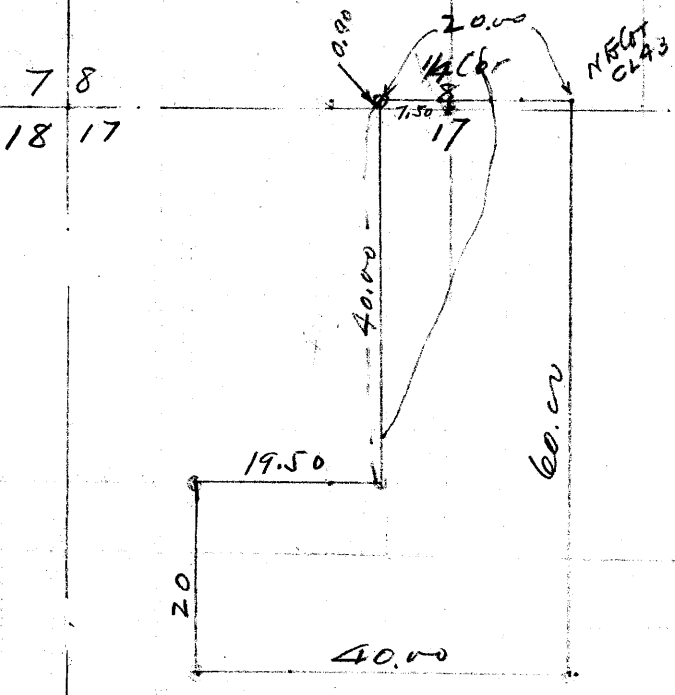

8 9 Nat 43° 03' 17" 9
 17 16 16

CS FILE FOLDER

CONTAINS

MORE

INFORMATION