


E. H. OTTINGER
DEED DESCRIPTIONS
SEC. 7 T26S R5W.

Office of the
COUNTY SURVEYOR
DOUGLAS COUNTY
OREGON

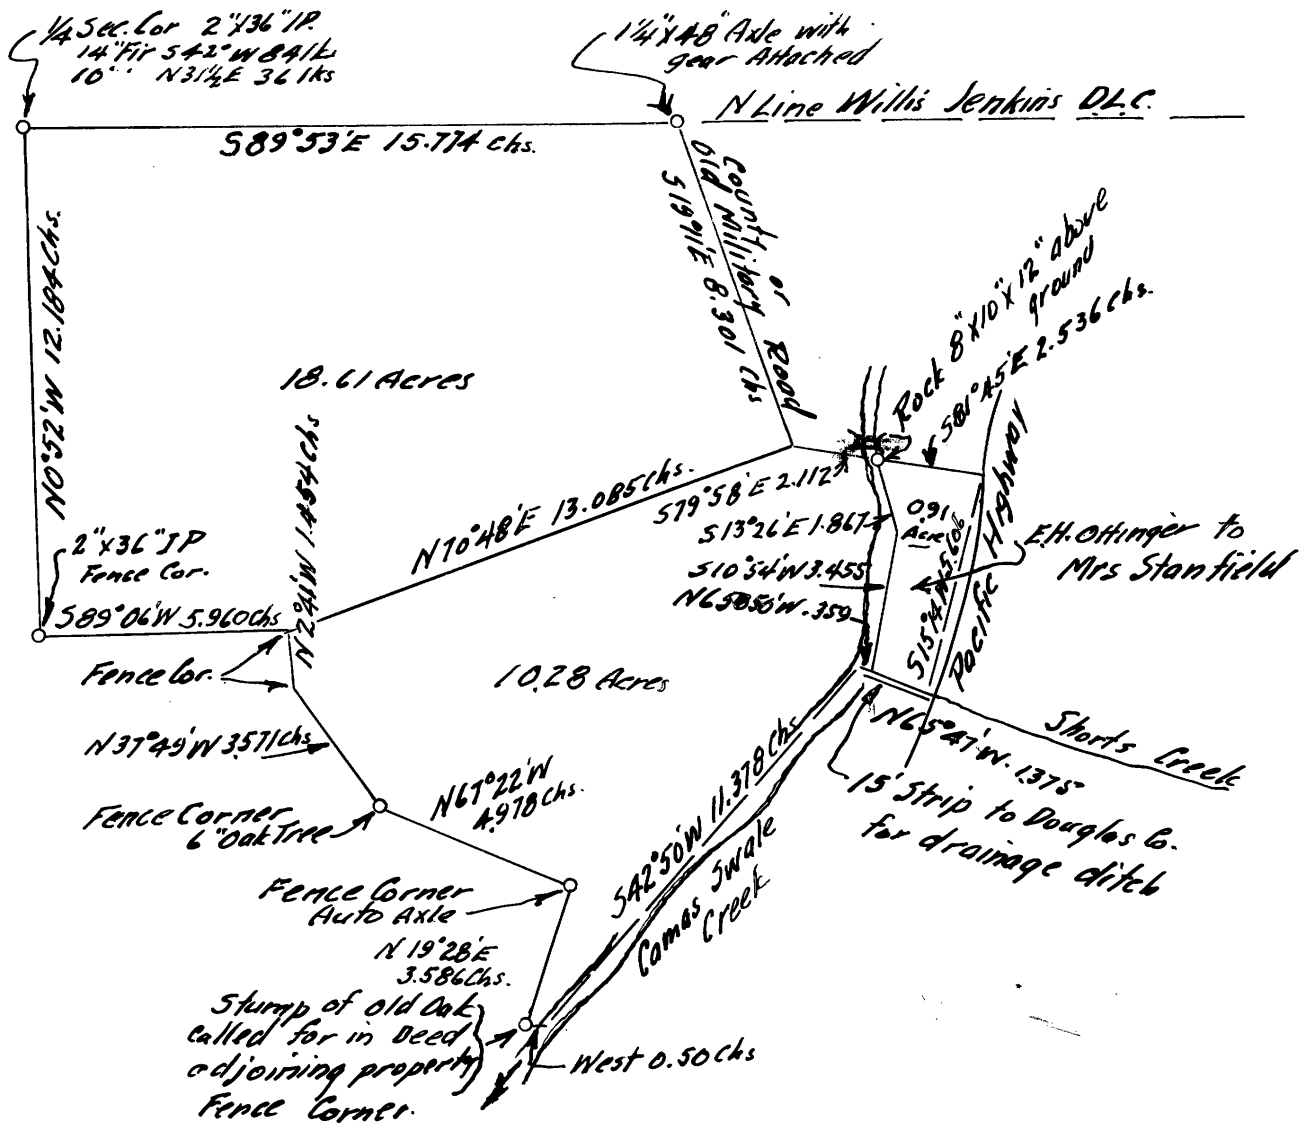

CS FILE FOLDER

CONTAINS

MORE

INFORMATION