


Reizenstein

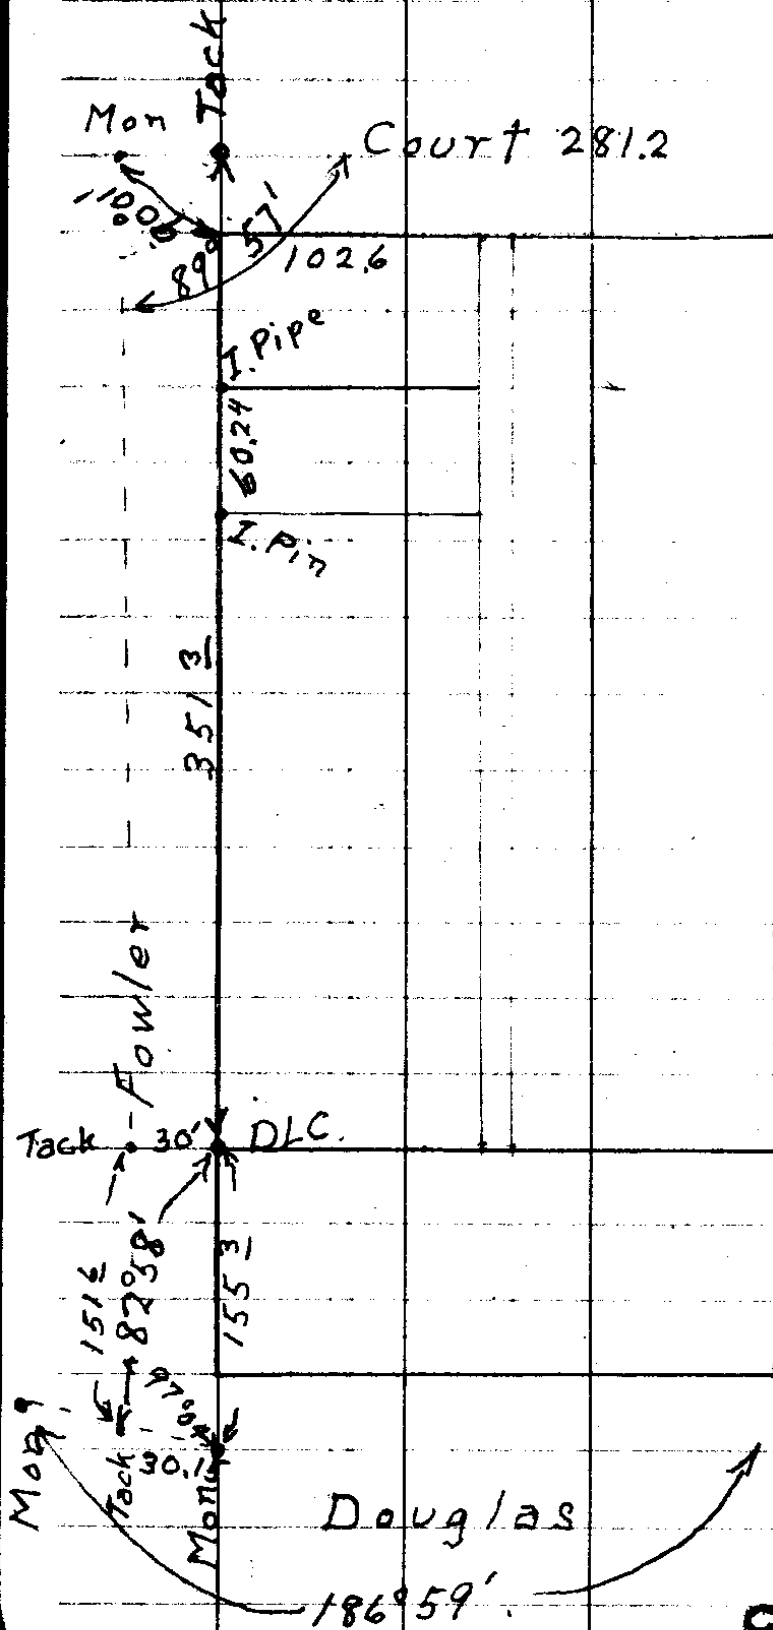

• Tack

Pitzer


• Mon

C.S. No. 23/2

23-2

L. Reizenstein Lot Survey

Aug. 23-35
Eppstein

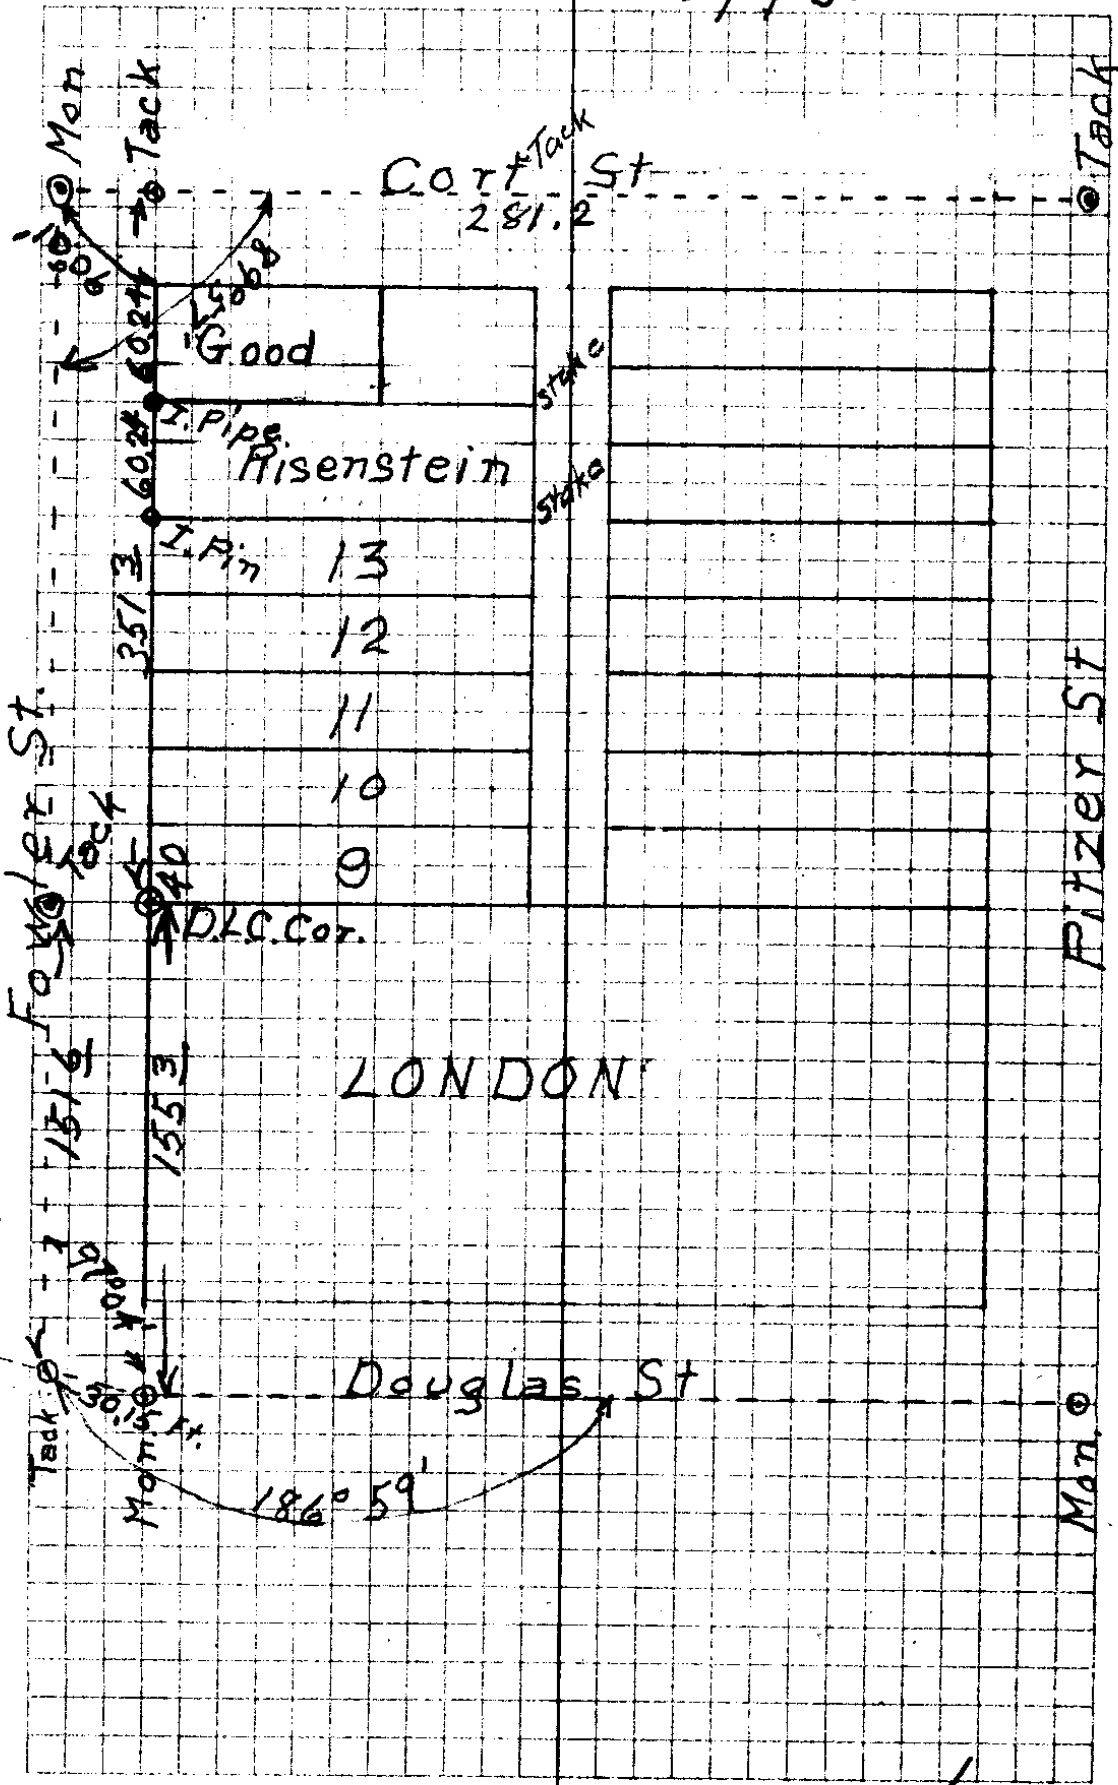

C. S. File No. 23/2

CS FILE FOLDER

CONTAINS

MORE

INFORMATION