

Map of Land


Surveyed Sep, 4, & 5, 1935, For W. A. Smith.

In Sec. 17

Scale, 200ft to 1 inch.

Township 26 S. R. 3 W. W.M.

23-3

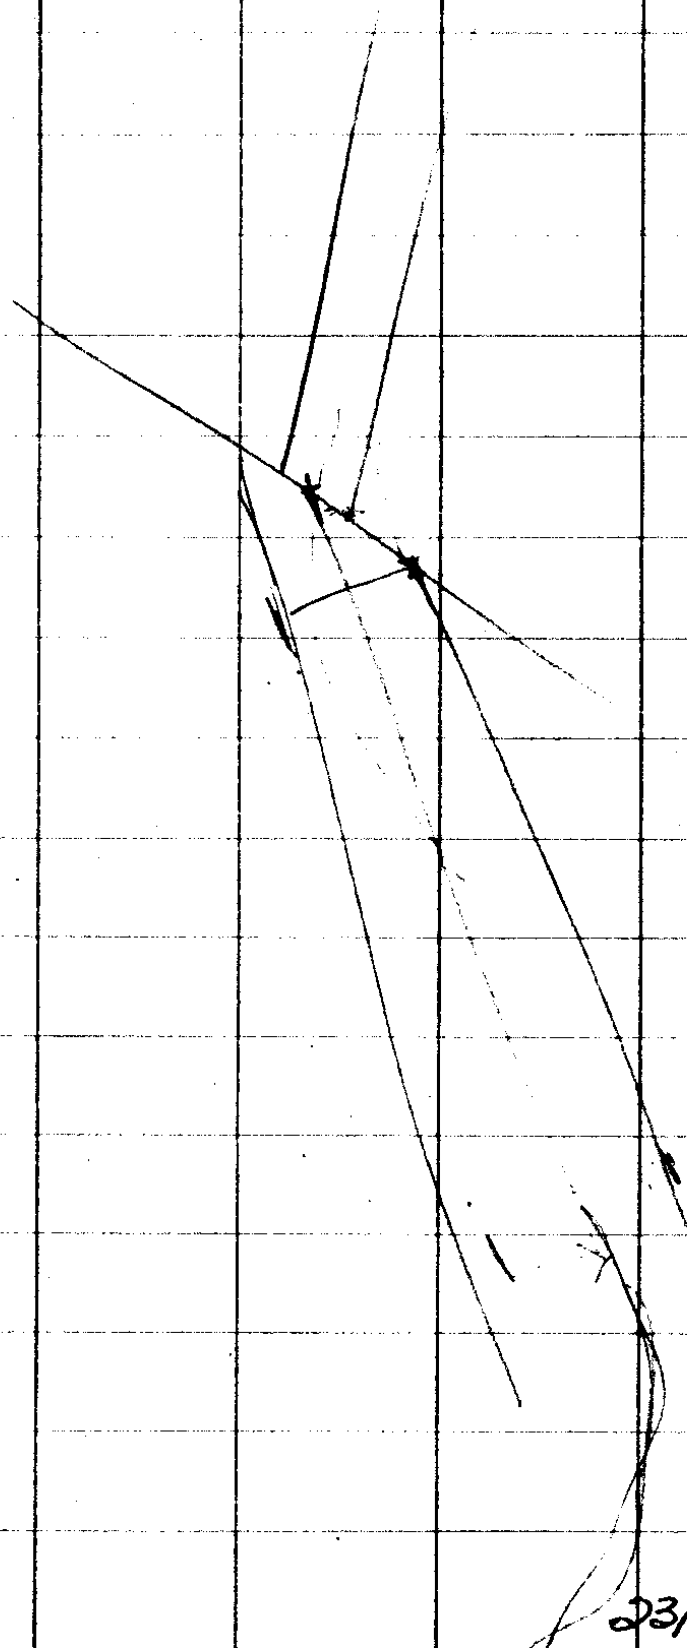

f 23/3

1

Cain K

Sep 4, 5, 1935

Richardson Cr.

Survey for W A Smith

Dist L. R. M.C. C.C.

123

6 Δ

S64¹/₄° E S64°24' E

162.3 21°08'

5 Δ

S45°0' S43°16' E

79.2

10°27'

4 Δ

S55° E S53°43' E

166.4

50°00'

3 Δ

(+ 29.5 to River)

N76°15' N76°17' E

440.5 ✓

68°13'

2 Δ

N8° E N8°04' E

321.0 ✓

78°16'

1 Δ

N69°45' N70°12' W

599.2 ✓

37°50' S72°29' W

0 Δ

21°08'

243°106'

31² Ft. to River Bank 150 Ft to Cent. River

a Fir 26" diameter (5/5) 1127/11 9-3/4

* 9 " 16" " " " " S. 79° E 31° 9'

5218 mm
 3 L TP MSC, CC

14A 10°25' 572°W 571°58'W

2078 ✓ 0°14'

13A ✓ 562°W 561°33'W

3222 ✓ 59°53'

12A ✓ 562°W 561°19'W

(+ 312 to River)
 5218 ✓ 136°05'

11A ✓ 51°05'W 51°26'W

1612 0°33'

10A N45½°E N45°21'E

3949 13°12'

9A N45°00'E N44°48'E

2237 13°37'

8A N58°E N58°00'E

2692 N3°59'

7A N72°E N71°37'E

69°108
 205 130

23-3

34
29

22 4

For description see next page

(5218)

To sec line 122E North of 25W

23/3

5

W A Smith - Description

Beginning at a point on Sec line

Bet Secs 16 & 17, T26 S R3 W, N1°26'E

122 ft from the 1/4 Cor bet Secs 16 & 17

Thence S61°19'N 322.4 ft ✓

" S61°33'N 207.8" ✓

" S71°58'N 599.2 "

" N70°12'W 321.0 ✓

" N. 8°04'E 470.0 ✓ to N Umpqua River

" N76°17'E 166.4 ✓ following River to Stream

" S53°43'E 79.1 ✓ "

" S43°11'E 162.2 ✓ "

" S. 64°24'E 123.0 ✓ "

" N71°37'E 269.0 ✓ "

N. 58° E 223.7 ✓

N44°48'E 394.9 ✓

N45°21'E 161.0 ✓ to line bet Secs 16 - 17

S 1°26'N 553.0 to beginning of Cont 12,89 acs

CS FILE FOLDER

CONTAINS

MORE

INFORMATION