


V23
E-7

~~23/7~~ 23/7

Tack previously set
by B.B.

Dec 20-35
Boyer
Richardson
J. Wolford this
set

Lined
to Sherman
Ave
St

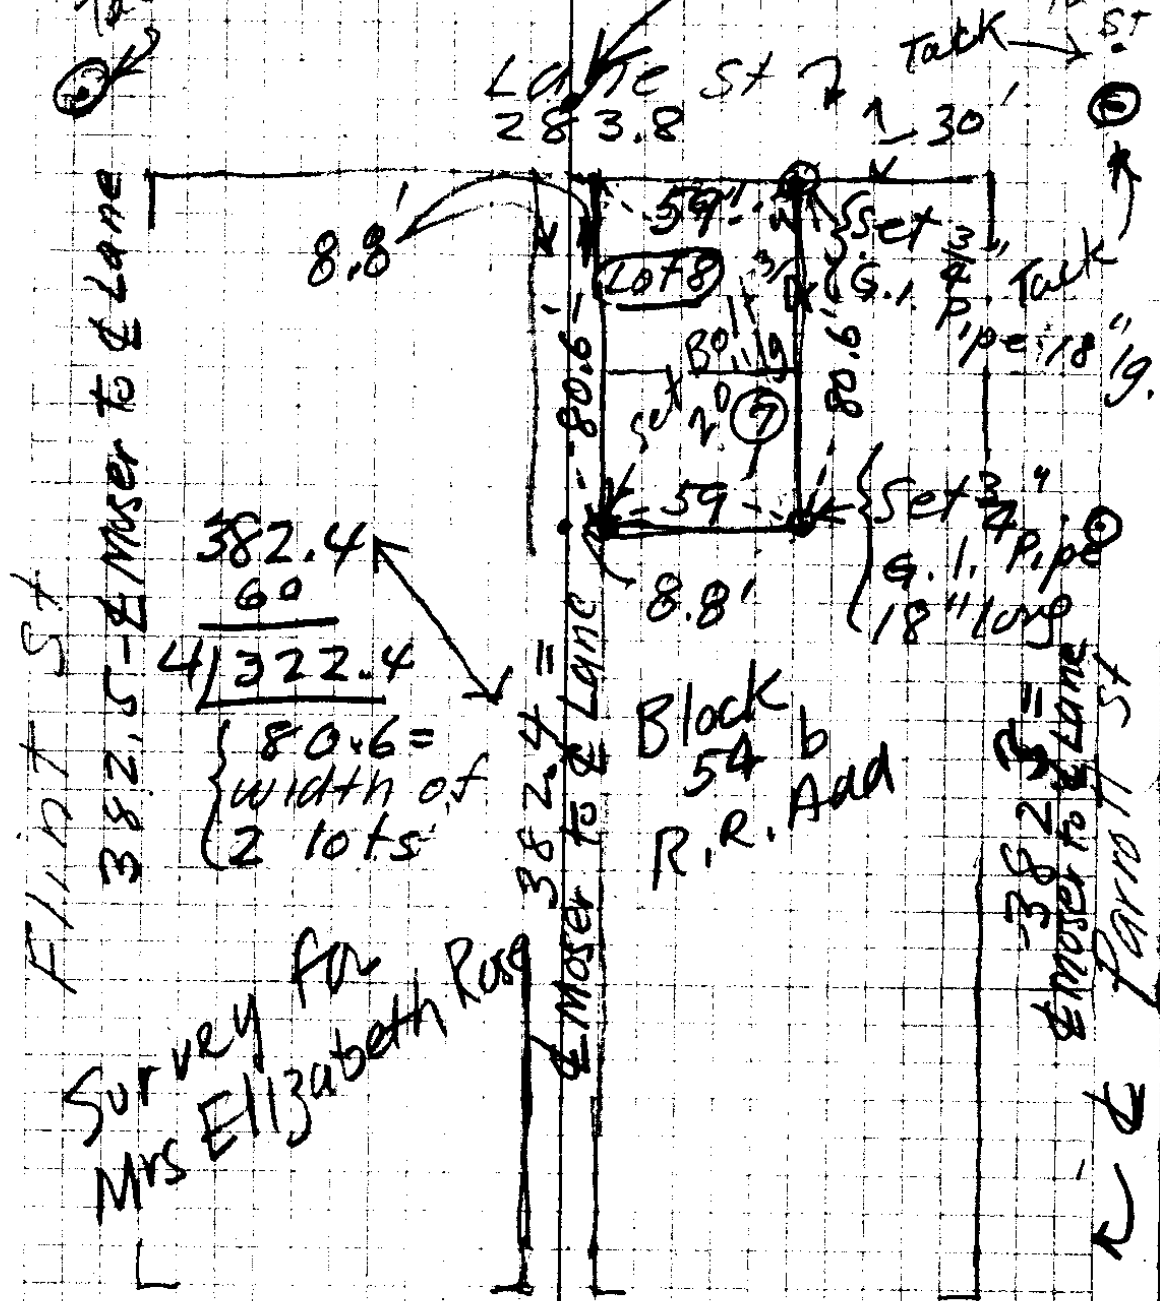

Lake St 2 Tack
283.8 1.30'

Survey for
Mrs Elizabeth Rose

Monument 284.2 142.1
Masher
set this point
Monument

OVER

P

23/7

23-7

Mrs Eliz. Rose

Survey of

" A Strip of Land 59' wd and
80' lg of the W. End of
Lots 7⁹⁴ & 8, being the
W. Frac. part of Lots
7 & 8, B1 38 b - R.R. Add.