


23-10

Mrs May Truman.
Camas V.

Initial P
Find this Pipe

June 12/
A Boyer
O.C. Weikel

333.00
147.8
152.2
<u>3.00</u>
452.2

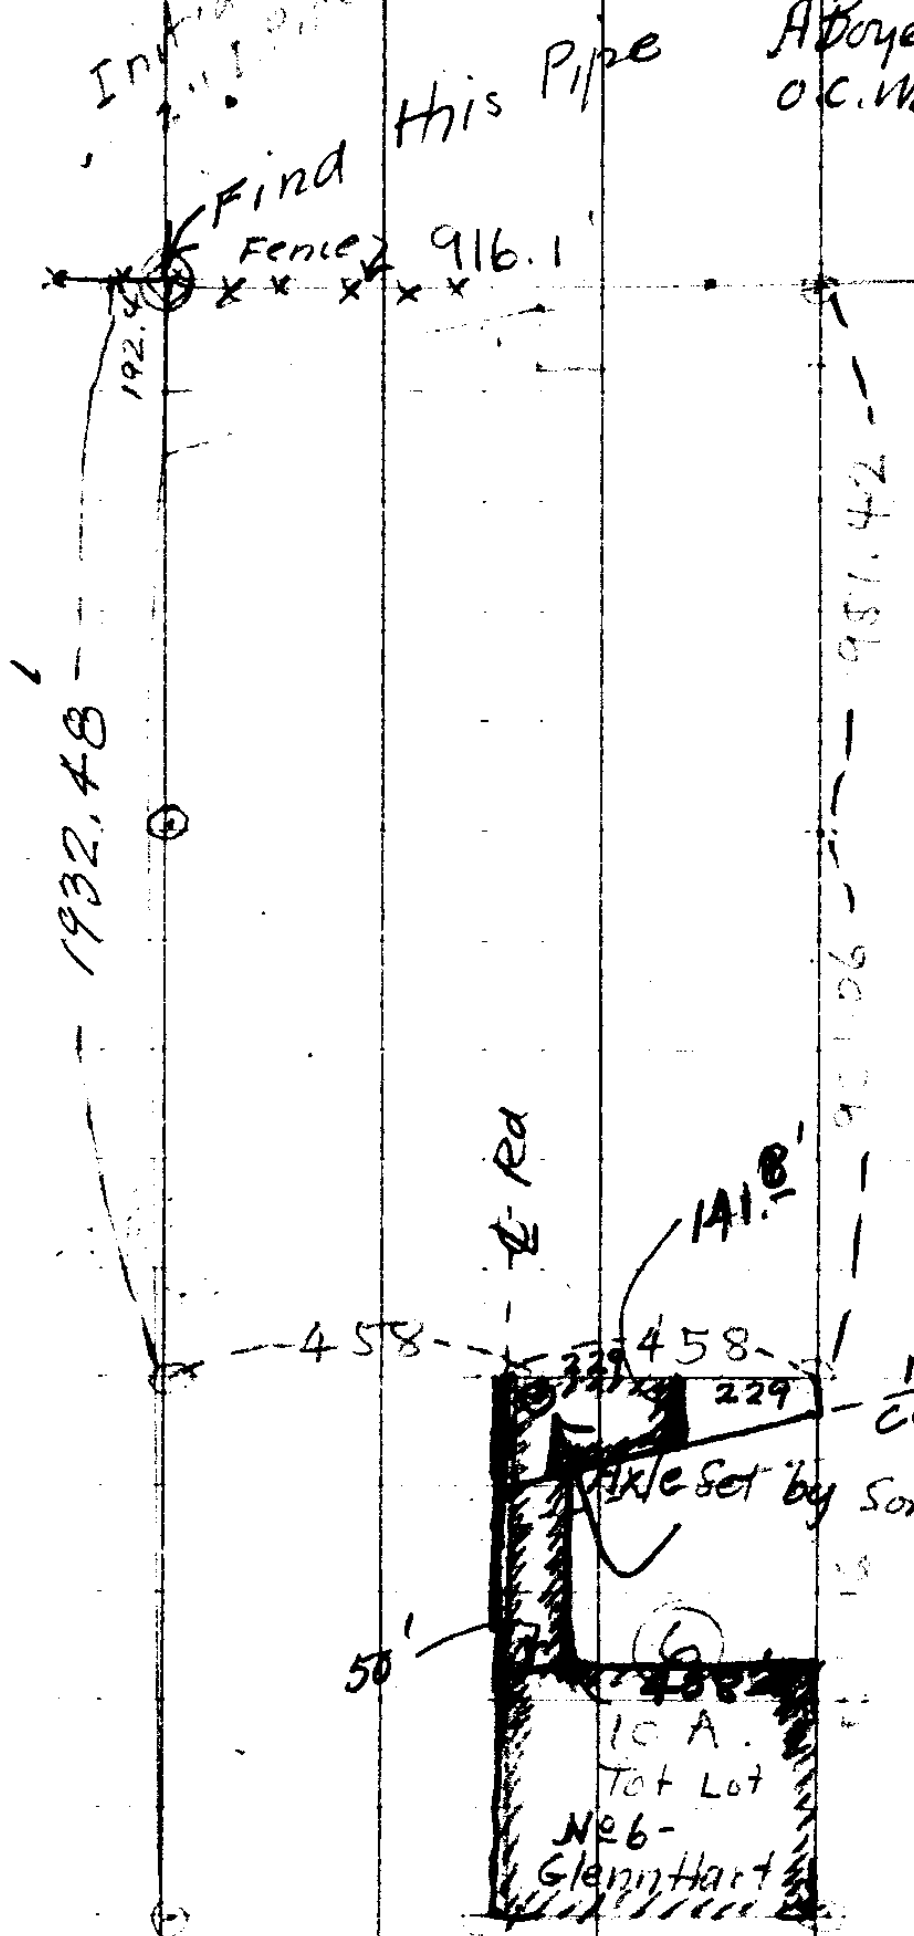

981.42
951.06
951.06
951.06
<u>3834.60</u>

981.42
951.06
<u>1932.48</u>
2458
<u>229</u>

Lot 6
Glenn Hart
Tract

451.06
to car

223
E 10

Fence

