

23-17 MAR-2-36 P.M.

A Boyer

Wayne Shaw

For

Mrs Rhobee  
Wallace

Established  
this →

1<sup>st</sup> ~~1000~~ Estab-  
lished  
this

E. 3<sup>RD</sup> AV. (N. 60)

Kinneys  
Improved  
Plat




B1-5

Lots 3 & 4

180° Found  
St Man  
Found  
St Man

3/4 1.P. 40' 1/9 14' 4' 18'  
5 1/2' 14' 4' 18'

Shed

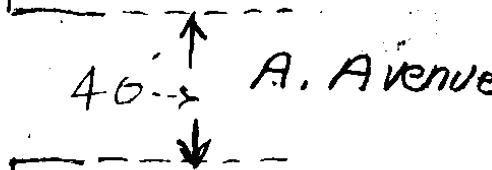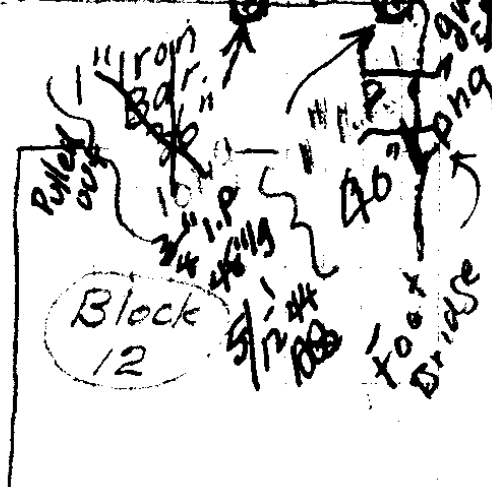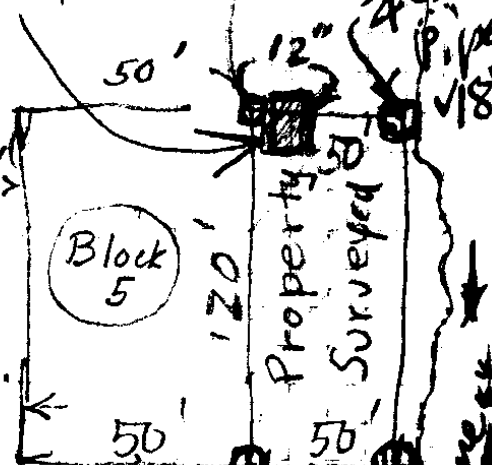

V. 23-E. 17