

23/22

3/4 1. P. 0

East Arrow Bar

N. Line Pruner Rd

Fence 4/6/36

3 E Cor

DLC 41

Pruner Rd

1" sq 1. Bar 48" lg

Worm Fence

CL 41-

52 2 1/2
82 2 1/2 E 40" B.O.


set 3/4" Bar 6' lg 4 1/2' in grd
at Pt E of N 1/4 cor 7 on
E. DLC Line + on N 77' S 40

C.S. File No. 23/22

NE Cor DLC 41

3 00
63
237

12 seedlg
Apple
Bar K
Scribe

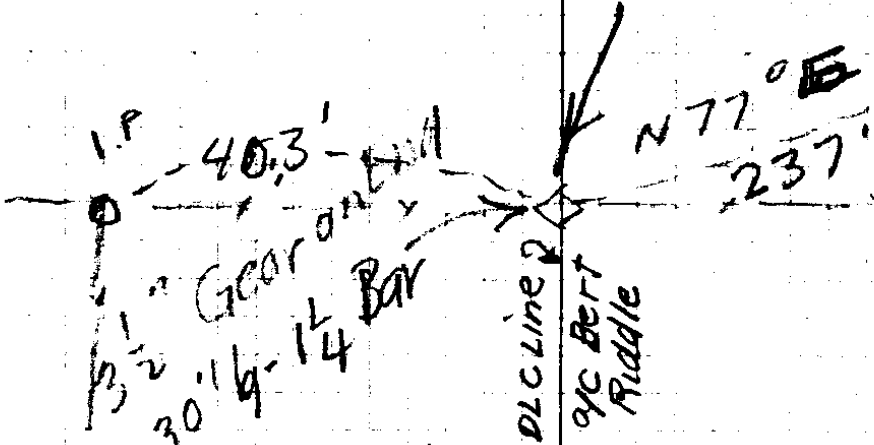

Dist bet NE + SE Cor

DLC 41 = 14.0 over

GLD DIST