


May 25/36

A Buyer  
Geo Matthews.

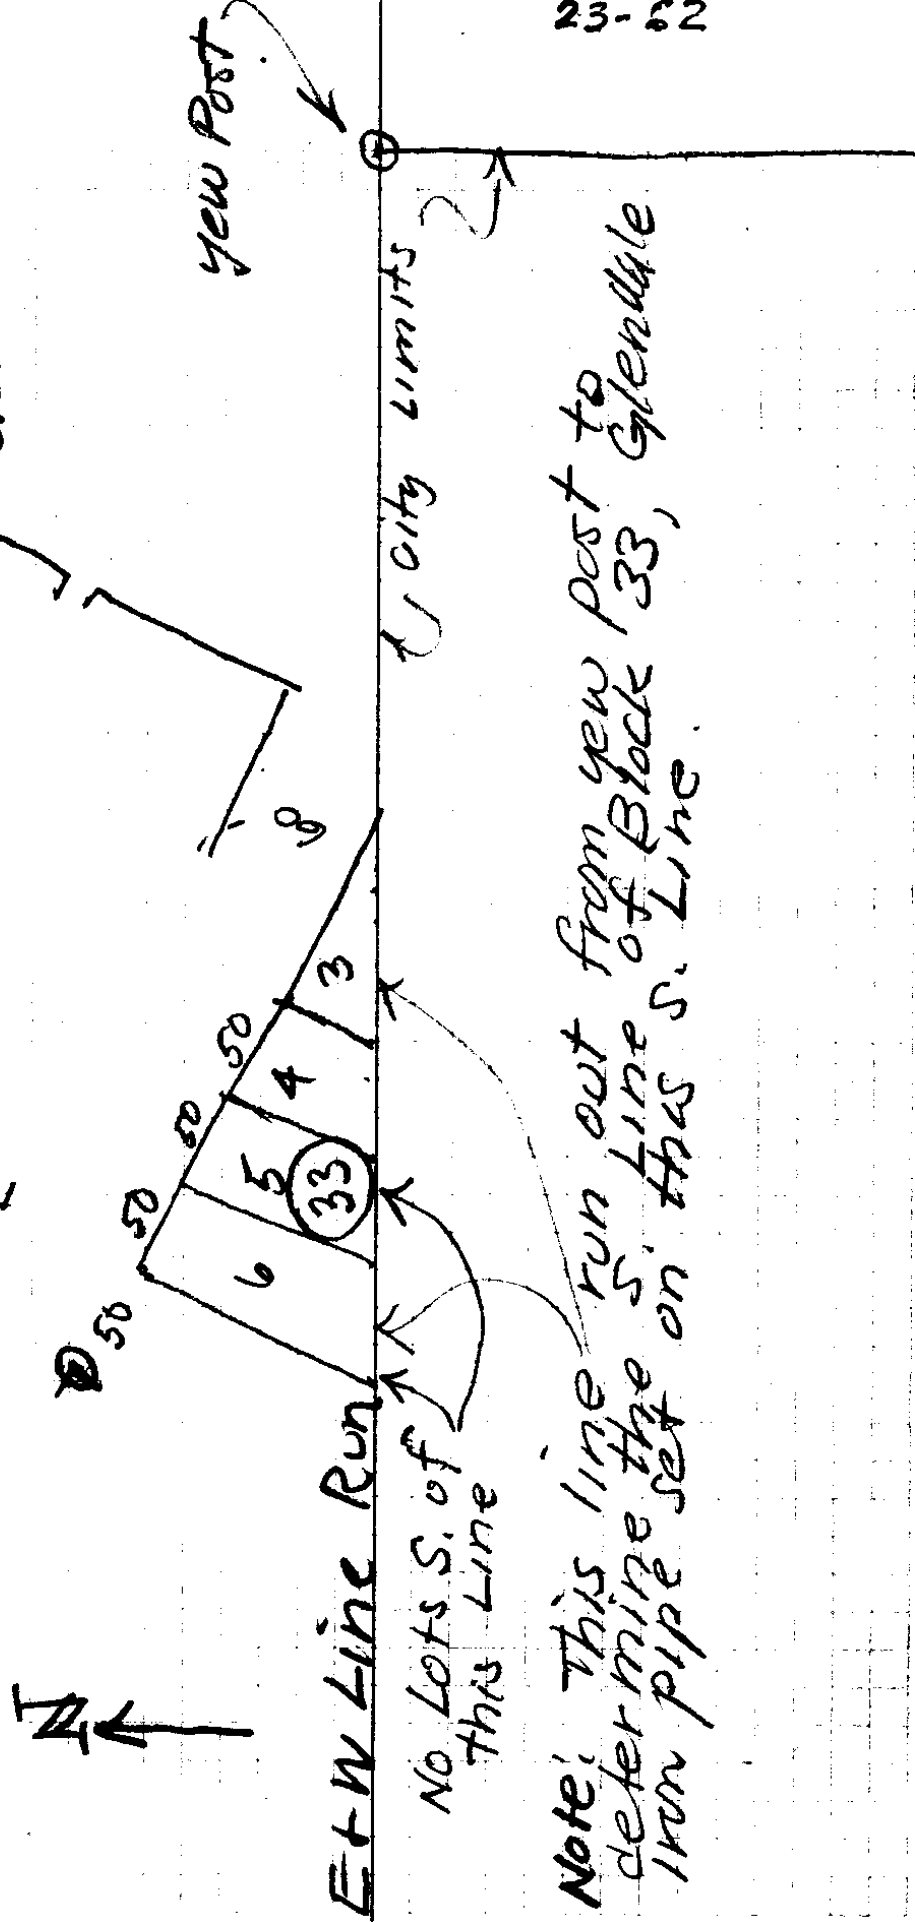

E-W Line Run

No Lots S. of  
this Line

Note: This line run out from new post to determine the S. Line of Block 33, Glendale Iron pipe set on this S. Line.

P.O. Bx 138      Glendale Ore.  
May 26<sup>th</sup>/36

Mr. A. Boyer  
Roseburg, Ore

Dear Sir

Received your letter  
this A.M. about the one and water  
jug, I intend to be in Roseburg  
June<sup>th</sup> and will get them for  
you. Please hold them until I come.  
I talked with Mr. Nelson last  
evening, he says the yellow wood  
post you measured from is the  
old city corner which all the  
city surveys in that part of the  
town have been made from for  
the past 30 yrs that he knows  
of also he gave me information

