

23-82

SW Cor PLC 47

15" Maple S 60° E 20.74 L

15" " S 53° E 19.5 "

T30S R6W

Henry Hart

Ray Compton

A Boyer

also Logsden & }
Wilson }

W.S

16.75 = 411

10.85

21.60 to Fence Post

9

30.6' Total Lift

10" - 350'

7" 350' ←

1500

700

1750

Crane - 6" int 5" dish

Cent. Pump

1.65 lks 3

	66	
990		
990		
99.90		


180
136
73 1/2

800' pipeline (Wilson
Logskin

1500 " " HAVEN

1150' - 7"

350' - 10"

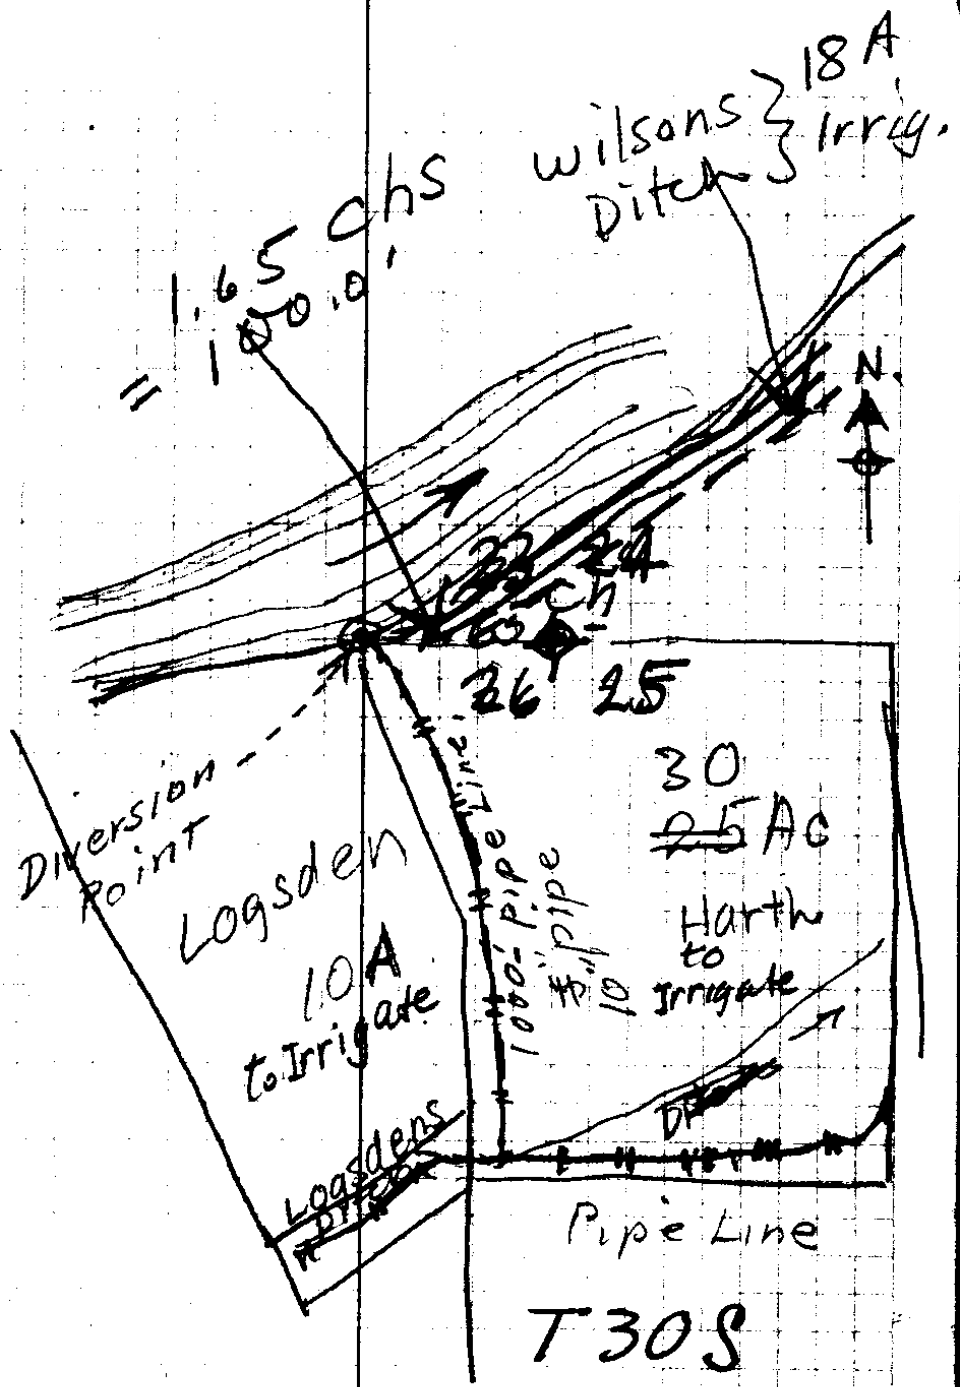


T 30 S
R 6 W

H Hartn }
Logsdon }
Wilson }

Aug. 20, 1936
A Boyer

23/82

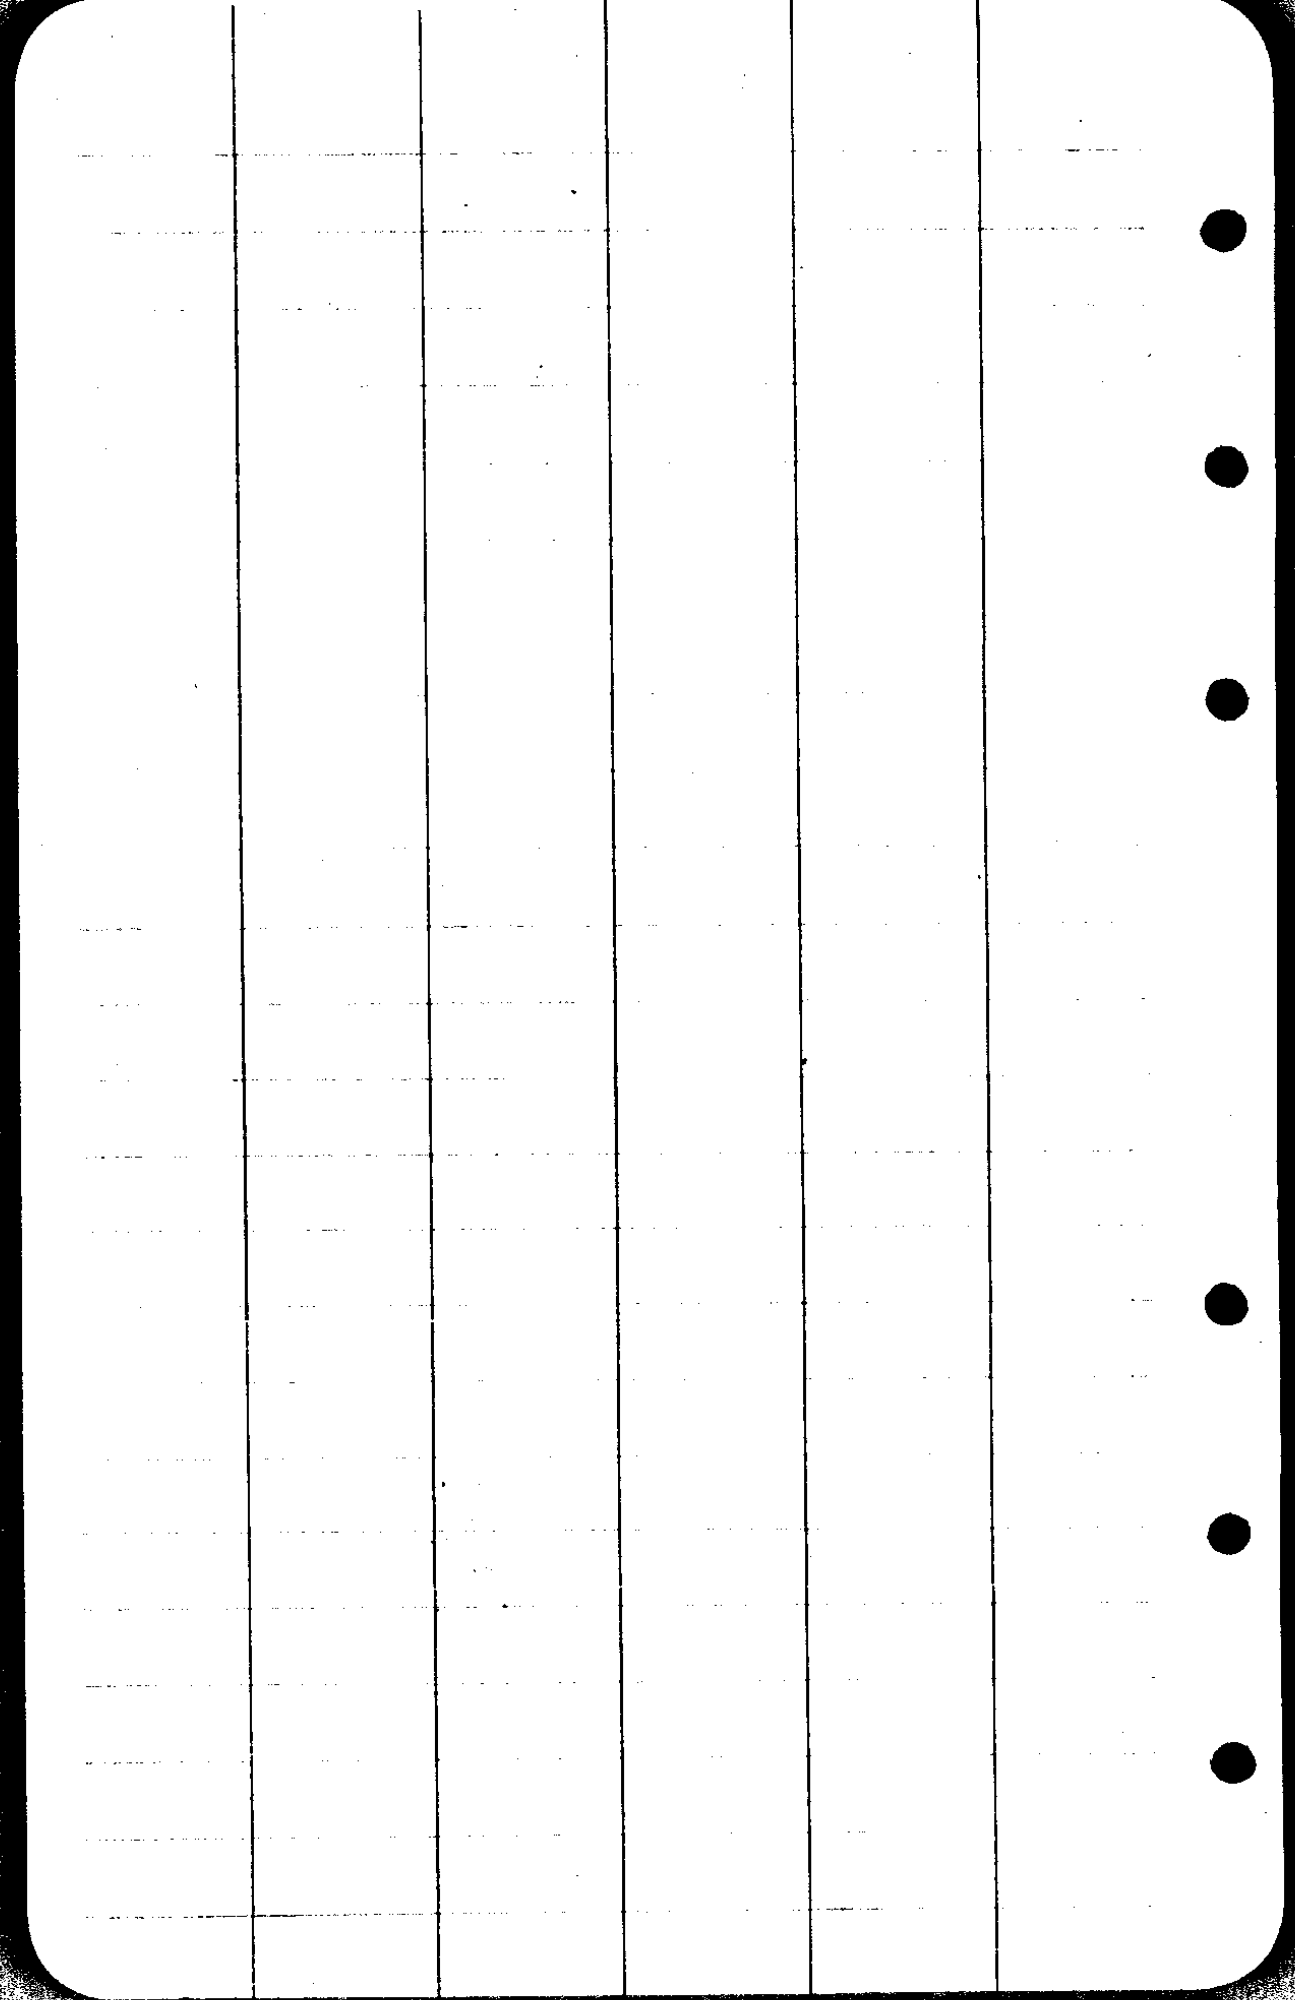

CS FILE FOLDER

CONTAINS

MORE

INFORMATION